

RECEIVED
JUN 9 1958

STATE ENGINEER
SALEM, OREGON

Registration No. GR 1686

Certificate No. GR 1636

Registration Statement

OF CLAIMANT OF RIGHT TO APPROPRIATE GROUND WATER

TO THE STATE ENGINEER OF OREGON:

I, Paul Miller

of Rt. 4, Box 338, Corvallis
(Mailing address)

County of Linn

State of Oregon, do hereby make application for a certificate of registration as evidence of a right to appropriate ground water.

- Source from which water is withdrawn is Pump Well No. 1
(Flowing well, pump well, infiltration trench, or tunnel)
- Location is: 3 miles East of Corvallis, Oregon
(Approximate distance and direction from nearest city or town)

and is more particularly described as follows:

- (a) N. 1° 45' E. 28 chains from SW corner S. 29, T. 11 S, R. 4 W.W.M.
(Give distance and bearing to corner of section or other legal subdivision)
- being within NW 1/4 of SW 1/4 of Sec. 29, Twp. 11 S, Rge. 4 W
(Smallest legal subdivision) (N. or S.) (E. or W.)
- or (b) within limits of recorded platted property, town or city:
- in Lot _____, Block _____ of _____
(Name of plat or addition)

County of Linn

(If within city or town, give name)

- Construction Work was begun on May 1955; was completed on May 1955
(Date) (Date)

and the ground water claimed was first used for the purposes set out below on May 1955
(Date)

since which time the water has been used continuously
(Continuously or Intermittently)

from May 1955 to present time
(Date) (Date)

- Quantity of water claimed and used is 250 gallons per minute; 58.0 acre feet per year.

- Purpose or Purposes for which water is used Irrigation

(Domestic, irrigation, municipal, manufacturing, industrial, etc.)

- Description of Well: Depth 24 feet. Type Drilled
(Dug or drilled)
- diameter 6 inches. Elevation of ground at well site 200 feet, mean sea level.
(As near as known)
- Depth to water table 10 feet.

- Capacity of Well: _____ g.p.m. with _____ feet drawdown.
_____ g.p.m. with _____ feet drawdown.


Date of test Not tested

If Flowing Well: Measured discharge _____ g.p.m. on _____
(Date)

Shut-in pressure at ground surface _____ lbs. per sq. in. on _____
(Date)

Water is controlled by _____
(Cap, valve, etc.)

Township 11 S Range 4 W W.M.
North

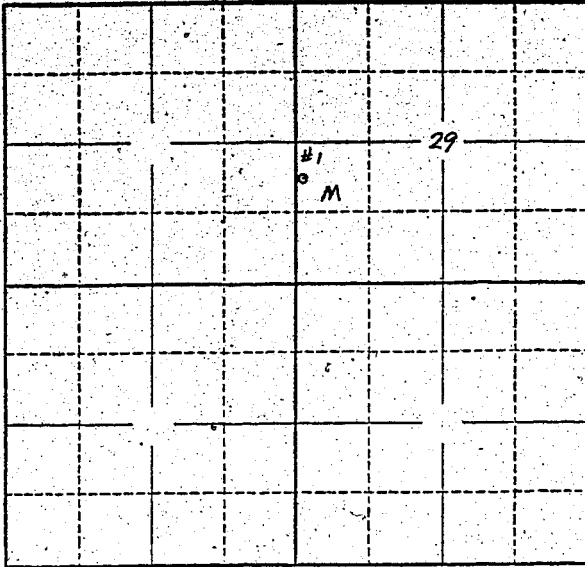

Locate well and acreage of irrigated land on plat.
Scale: 2" = 1 Mile

STATE OF OREGON

County of LINN

} ss.

I, Paul Miller, being first duly sworn, do hereby certify that I have read the foregoing Registration Statement and that all of the items therein contained are true to the best of my knowledge and belief.

Paul Miller
(Signature of Registrant)

Subscribed and sworn to before me this 6th day of June, 1958.

My commission expires MY COMMISSION EXPIRES FEB. 18, 1959

Joy Conchie
(Notary Public)

(SEAL)

CERTIFICATE OF REGISTRATION

STATE OF OREGON

County of Marion

} ss.

This is to certify that the foregoing Registration Statement was received in the office of the State Engineer on the 9th day of June, 1958, at 8:00 o'clock A. M. and has been duly recorded in said office in Book No. 8 of Registration Statements on page GR-1636

Witness my hand this 7th day of January, 1959.

Leora A. Atanley
(State Engineer)

#15.00

By _____ (Deputy)

GR-1636