

RECEIVED
JUN 9 1958

Registration Statement

STATE ENGINEER
SALEM, OREGON

OF CLAIMANT OF RIGHT TO APPROPRIATE GROUND WATER

TO THE STATE ENGINEER OF OREGON:

I, Paul Miller

of Rt. 4, Box 338, Corvallis County of Linn
(Mailing address)

State of Oregon, do hereby make application for a certificate of registration as evidence of a right to appropriate ground water.

1. Source from which water is withdrawn is Pump Well No. 3
(Flowing well, pump well, infiltration trench, or tunnel)

2. Location is: 3 miles West of Corvallis, Oregon
(Approximate distance and direction from nearest city or town)

and is more particularly described as follows:

(a) N. 42° 35' W, 11 chains from SE corner of S. 30, T. 11 S, R. 4 W.
(Give distance and bearing to corner of section or other legal subdivision)

being within SE $\frac{1}{4}$ of SE $\frac{1}{4}$ of Sec. 30, Twp. 11 S, Rge. 4 W
(Smallest legal subdivision) (N. or S.) (E. or W.)

or (b) within limits of recorded platted property, town or city:

in Lot _____, Block _____ of _____
(Name of plat or addition)

County of Linn
(If within city or town, give name)

3. Construction Work was begun on 1952; was completed on 1952
(Date) (Date)

and the ground water claimed was first used for the purposes set out below on July 5, 1953
(Date)

since which time the water has been used continuously
(Continuously or intermittently)

from July 5, 1953 to present time
(Date) (Date)

4. Quantity of water claimed and used is 350 gallons per minute; 121.5 acre feet per year.

5. Purpose or Purposes for which water is used Irrigation

(Domestic, irrigation, municipal, manufacturing, industrial, etc.)

6. Description of Well: Depth 38 feet. Type Drilled
(Dug or drilled)

diameter 8 inches. Elevation of ground at well site 210 feet, mean sea level.
(As near as known)

Depth to water table 25 feet.

7. Capacity of Well: 400 g.p.m. with 10 feet drawdown.

_____ g.p.m. with _____ feet drawdown.


Date of test July 5, 1953

If Flowing Well: Measured discharge _____ g.p.m. on _____
(Date)

Shut-in pressure at ground surface _____ lbs. per sq. in. on _____
(Date)

Water is controlled by _____
(Cap, valve, etc.)

Township 11 S Range 4 W, W.M.
North

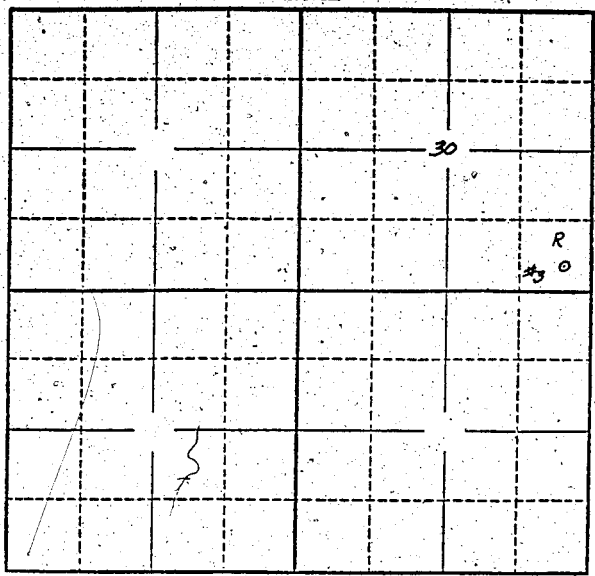

Locate well and acreage of irrigated land on plat.
Scale: 2" = 1 Mile

STATE OF OREGON

County of LINN } ss.

I, Paul Miller, being first duly sworn, do hereby certify that I have read the foregoing Registration Statement and that all of the items therein contained are true to the best of my knowledge and belief.

Paul Miller
(Signature of Registrant)

Subscribed and sworn to before me this 6th day of June, 1958
MY COMMISSION EXPIRES FEB. 18, 1959

Ray Conchie
(Notary Public)

My commission expires _____
(SEAL)

CERTIFICATE OF REGISTRATION

STATE OF OREGON

County of Marion } ss.

This is to certify that the foregoing Registration Statement was received in the office of the State Engineer on the 9th day of June, 1958, at 8:00 o'clock A. M. and has been duly recorded in said office in Book No. 8 of Registration Statements on page GR-1638

Witness my hand this 7th day of January, 1959

Lewis A. Stanley
(State Engineer)

18 ⁰⁰

By _____
(Deputy)

GR - 1638