

Registration Statement

OF CLAIMANT OF RIGHT TO APPROPRIATE GROUND WATER

TO THE STATE ENGINEER OF OREGON:

I, Busenbark Brothers

of Rte #3 Box 470, Roseburg, Oregon County of Douglas

State of Oregon do hereby make application for a certificate of registration as evidence of a right to appropriate ground water.

1. Source from which water is withdrawn is dump well
(Flowing well, pump well, infiltration trench, or tunnel)

2. Location is: 6 miles northwest of Roseburg
(Approximate distance and direction from nearest city or town)

and is more particularly described as follows:

APPROX 1380' N 82° 45' W from SW cor Sec 4
Beginning at the interior L. corner of D.L.C #50 in TWP 27S Range 6 W.W.M., thence north 1477.9 feet; thence N 30° 22' W 600 feet thence N 76° 04' W 912 feet to well.

County of _____
(If within city or town, give name)

3. Construction Work was begun on September 1943; was completed on May 1944
(Date) (Date)

and the ground water claimed was first used for the purposes set out below on May 1944
(Date)

since which time the water has been used continuously
(Continuously or intermittently)

from June to Sept.
(Date) (Date)

4. Quantity of water claimed and used is 110 gallons per minute; _____ acre feet per year.

5. Purpose or Purposes for which water is used irrigation

(Domestic, irrigation, municipal, manufacturing, industrial, etc.)

6. Description of Well: Depth 22 feet. Type dig
(Dug or drilled)

diameter 18 inches. Elevation of ground at well site 400 feet, mean sea level.
(As near as known)

Depth to water table 7 feet.

7. Capacity of Well: 110 g.p.m. with 13' feet drawdown. June

100 g.p.m. with 14' feet drawdown. August


Date of test _____

If Flowing Well: Measured discharge _____ g.p.m. on _____
(Date)

Shut-in pressure at ground surface _____ lbs. per sq. in. on _____
(Date)

Water is controlled by _____
(Cap, valve, etc.)

Township 27S Range 6W W.M.
North

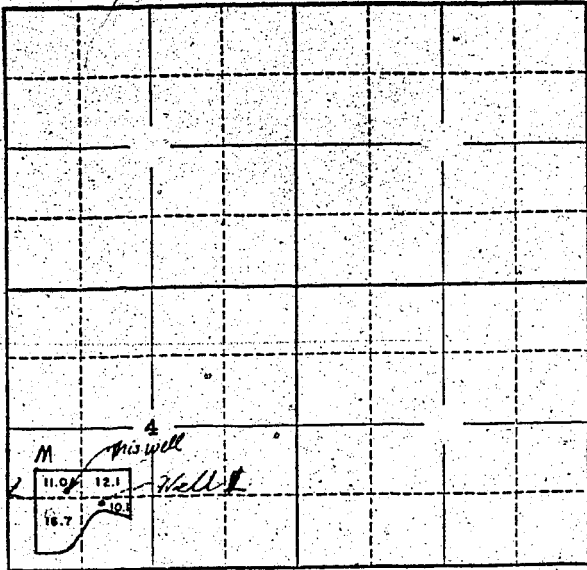

Locate well and acreage of irrigated land on plat.

Scale: 2" = 1 Mile

STATE OF OREGON

County of Douglas } ss.

I, T. B. Buserbach, being first duly sworn, do hereby certify that I have read the foregoing Registration Statement and that all of the items therein contained are true to the best of my knowledge and belief.

Buserbach Bros
T. B. Buserbach
(Signature of Registrant)

Subscribed and sworn to before me this 6th day of June, 1958

My commission expires Aug 8, 1958

[Signature]
(Notary Public)

(SEAL)

CERTIFICATE OF REGISTRATION

STATE OF OREGON

County of Marion } ss.

This is to certify that the foregoing Registration Statement was received in the office of the State Engineer on the 9th day of June, 1958, at 8:00 o'clock A.M. and has been duly recorded in said office in Book No. 8 of Registration Statements on page GR-1640

Witness my hand this 7th day of January, 1959

Lewis A. Stanley
(State Engineer)

By _____
(Deputy)

\$15.00