

RECEIVED  
JUN 9 1958

STATE ENGINEER  
SALEM, OREGON

Registration No. GR 1691

Certificate No. GR 1641

### Registration Statement

#### OF CLAIMANT OF RIGHT TO APPROPRIATE GROUND WATER

TO THE STATE ENGINEER OF OREGON:

I, Busenbark Brothers *Well #1*

of Rt #3, Box 470, Roseburg County of Douglas  
(Mailing address)

State of Oregon, do hereby make application for a certificate of registration as evidence of a right to appropriate ground water.

1. Source from which water is withdrawn is DUMP well #1  
(Flowing well, pump well, infiltration trench, or tunnel)

2. Location is: 6 miles northwest of Roseburg  
(Approximate distance and direction from nearest city or town)

and is more particularly described as follows:

Beginning at the interior L. corner of D.L.C. #50 in TWP-27s Range 6 W.W.M., thence north 1477.9 feet; thence N39°22' W 651.2 feet to the well.

County of \_\_\_\_\_  
(If within city or town, give name)

3. Construction Work was begun on May 1936; was completed on Sept. 1936  
(Date) (Date)

and the ground water claimed was first used for the purposes set out below on May 1937  
(Date)

since which time the water has been used continuously  
(Continuously or Intermittently)

from June to Sept.  
(Date) (Date)

4. Quantity of water claimed and used is 130 gallons per minute; \_\_\_\_\_ acre feet per year.

5. Purpose or Purposes for which water is used irrigation

(Domestic, irrigation, municipal, manufacturing, industrial, etc.)

6. Description of Well: Depth 18 1/2 feet. Type Dug  
(Dug or drilled)

diameter 48 inches. Elevation of ground at well site 400 feet, mean sea level.  
(As near as known)

Depth to water table 12 feet.

7. Capacity of Well: 130 g.p.m. with 2 feet drawdown. June

130 g.p.m. with 6 feet drawdown. August

Date of test \_\_\_\_\_

If Flowing Well: Measured discharge \_\_\_\_\_ g.p.m. on \_\_\_\_\_  
(Date)

Shut-in pressure at ground surface \_\_\_\_\_ lbs. per sq. in. on \_\_\_\_\_  
(Date)

Water is controlled by \_\_\_\_\_  
(Cap, valve, etc.)

8. Casing: (Give diameter, commercial specifications and depth below ground surface of each casing size.)

48 inch diameter round from to feet  
 inch diameter from to feet  
 inch diameter from to feet  
 inch diameter from to feet

Describe and show depth of shoe, plug, adapter, liner or other details: \_\_\_\_\_

none

9. Perforated Casings or Screens:

(Number per foot and size of perforations, or describe screen) from to  
 from to  
 from to  
 from to

10. Log of Well: (Describe each stratum or formation clearly, indicate if water bearing, and give thickness and depth as indicated.)

MATERIAL	Thickness (Feet)	Depth to Bottom (Feet)
Sandy Loam	16	gravel to bottom

If log of well is not available, give name and address of driller. \_\_\_\_\_

11. Infiltration Trench: Covered or open \_\_\_\_\_

Dimensions: Length \_\_\_\_\_ ft. Minimum depth \_\_\_\_\_ ft. Maximum depth \_\_\_\_\_ ft.  
 Bottom width \_\_\_\_\_ ft. Discharge \_\_\_\_\_ g.p.m. Date of test \_\_\_\_\_

12. Tunnel: Type of lining \_\_\_\_\_

Dimensions: \_\_\_\_\_  
(Length, course, and cross sectional size)  
 Position of water bearing stratum with reference to portal of tunnel \_\_\_\_\_

Log of tunnel: (Preceding table for log of well may be used, if desired. Give footage from portal and character of materials, as pertinent.)

13. Pumping Equipment:

(a) Pump 1 1/2" Fairbanks Morse Capacity 165 g.p.m.  
(Make, type and size)  
 (b) Motor Fairbanks Morse Direct connected single phase 7 1/2 H.P.  
(Type and horsepower)

14. Location of area irrigated or to be irrigated, or place of use if for purposes other than irrigation.


Township North or South	Range E. or W. of Willamette Meridian	Section	Forty-acre Tract	Number Acres To Be Irrigated	Date of Reclamation
27S	6W	11	NE OF SW	12.1	1937
27S	6W	11	SE of SW	10.1	"
				<u>22.2</u>	"

15. If the ground water supply is supplemental to an existing water supply, identification of any application for a permit, permit, certificate or adjudicated right to appropriate water made or held by the registrant.

\_\_\_\_\_

\_\_\_\_\_

Township 27S Range 6W, W.M.  
North

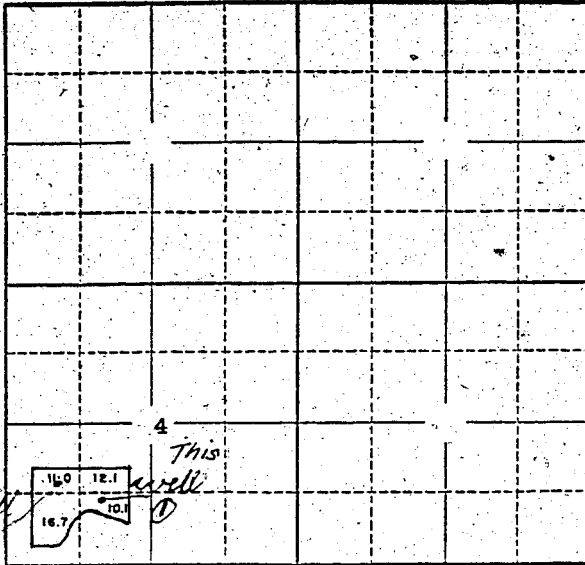

Locate well and acreage of irrigated land on plat.  
Scale: 2" = 1 Mile

STATE OF OREGON

County of Douglas } ss.

I, T. B. Burenbank, being first duly sworn, do hereby certify that I have read the foregoing Registration Statement and that all of the items therein contained are true to the best of my knowledge and belief.

T. B. Burenbank  
(Signature of Registrant)

Subscribed and sworn to before me this 6th day of June, 1958

My commission expires Aug 8, 1958 [Signature]  
(Notary Public)

(SEAL)

CERTIFICATE OF REGISTRATION

STATE OF OREGON

County of Marion } ss.

This is to certify that the foregoing Registration Statement was received in the office of the State Engineer on the 9th day of June, 1958, at 5:00 o'clock A. M. and has been duly recorded in said office in Book No. 8 of Registration Statements on page GR-1641

Witness my hand this 7th day of January, 1959

Lewis A. Stanley  
(State Engineer)

By \_\_\_\_\_ (Deputy)

4.15.00

GR-1641