

RECEIVED
APR 21 1958

STATE ENGINEER
SALEM, OREGON

RECEIVED
JUN 10 1958

STATE ENGINEER
SALEM, OREGON

Registration No. GR 1693

Certificate No. GR 1643

Registration Statement

OF CLAIMANT OF RIGHT TO APPROPRIATE GROUND WATER

TO THE STATE ENGINEER OF OREGON:

I, J. FRANK SCHMIDT, JR.

of 19343 N. E. Halsey Street, Troutdale County of Multnomah
(Mailing address)

State of Oregon, do hereby make application for a certificate of registration as evidence of a right to appropriate ground water.

1. Source from which water is withdrawn is Pump Well
(Flowing well, pump well, infiltration trench, or tunnel)

2. Location is: Three miles west of Troutdale.
(Approximate distance and direction from nearest city or town)

and is more particularly described as follows:

(a) 1700' West and 570' North of the S.E. Corner of Section 29.
(Give distance and bearing to corner of section or other legal subdivision)

being within Tax lot #41 (SW 1/4 SE 4) of Sec. 29, Twp. 1 N., Rge. 3 E.
(Smallest legal subdivision) (N. or S.) (E. or W.)

or (b) within limits of recorded platted property, town or city:

in Lot _____, Block _____ of _____
(Name of plat or addition)

County of Multnomah
(If within city or town, give name)

3. Construction Work was begun on June 1946; was completed on July 1946
(Date) (Date)

and the ground water claimed was first used for the purposes set out below on July 1946
(Date)

since which time the water has been used Continuously
(Continuously or intermittently)

from July 1946 to April 1958
(Date) (Date)

4. Quantity of water claimed and used is 120 gallons per minute; 2 1/2 acre feet per year.

5. Purpose or Purposes for which water is used Irrigation

(Domestic, irrigation, municipal, manufacturing, industrial, etc.)

6. Description of Well: Depth 142'3" feet. Type Drilled
(Dug or drilled)

diameter 8 inches. Elevation of ground at well site 140 feet, mean sea level.
(As near as known)

Depth to water table 55 feet.

7. Capacity of Well: 120 g.p.m. with 90 feet drawdown.

_____ g.p.m. with _____ feet drawdown.

Date of test 1950

If Flowing Well: Measured discharge _____ g.p.m. on _____
(Date)

Shut-in pressure at ground surface _____ lbs. per sq. in. on _____
(Date)

Water is controlled by _____
(Cap, valve, etc.)

8. Casing: (Give diameter, commercial specifications and depth below ground surface of each casing size.)

8	inch diameter	from	0	to	142'3"	feet
	inch diameter	from		to		feet
	inch diameter	from		to		feet
	inch diameter	from		to		feet

Describe and show depth of shoe, plug, adapter, liner or other details:

9. Perforated Casings or Screens:

Perforated	from	to
(Number per foot and size of perforations, or describe screen)	65	80
	85	100
	104	120
	123	137

10. Log of Well: (Describe each stratum or formation clearly, indicate if water bearing, and give thickness and depth as indicated.)

[illegible]



















Township 1 N. Range 3 E. W.M.
North

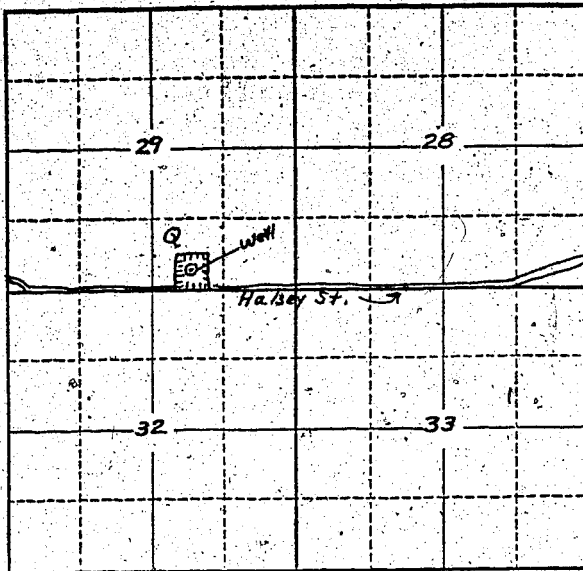

Locate well and acreage of irrigated land on plat.
Scale: 2" = 1 Mile

STATE OF OREGON

County of Washington

ss.

I, J. Frank Schmidt, Jr., being first duly sworn, do hereby certify that I have read the foregoing Registration Statement and that all of the items therein contained are true to the best of my knowledge and belief.

J. Frank Schmidt, Jr.
(Signature of Registrant)

Subscribed and sworn to before me this 24th day of April, 1958

My commission expires Aug 6, 1958

Franklin C. Hensley
(Notary Public)

(SEAL)

CERTIFICATE OF REGISTRATION

STATE OF OREGON

County of Marion

ss.

This is to certify that the foregoing Registration Statement was received in the office of the State Engineer on the 10th day of June, 1958, at 8:00 o'clock A. M. and has been duly recorded in said office in Book No. 8 of Registration Statements on page GR-1643

Witness my hand this 7th day of January, 1959

Lewis A. Stanley
(State Engineer)

By

(Deputy)

GR - 1643

\$15.00