

# Registration Statement

## OF CLAIMANT OF RIGHT TO APPROPRIATE GROUND WATER

TO THE STATE ENGINEER OF OREGON:

I. ALFRED M. HAENER

of INDEPENDENCE RT. 1 BOX 57 County of POLK  
(Mailing address)

State of OREGON, do hereby make application for a certificate of registration as evidence of a right to appropriate ground water.

1. Source from which water is withdrawn is PUMP WELL #1  
(Flowing well, pump well, infiltration trench, or tunnel)

2. Location is: 7 MILES SOUTH EAST OF INDEPENDENCE;  
(Approximate distance and direction from nearest city or town)

and is more particularly described as follows:

(a) 1320 FT. W. AND 760 FT. N. AND 15 FT. W. OF S.E. CORNER OF SECTION 1  
(Give distance and bearing to corner of section or other legal subdivision)

being within SW 1/4 OF THE SE 1/4 of Sec. 1, Twp. 9S., Rge. 4W.  
(Smallest legal subdivision) (N. or S.) (E. or W.)

or (b) within limits of recorded platted property, town or city: \_\_\_\_\_ of \_\_\_\_\_

in Lot \_\_\_\_\_, Block \_\_\_\_\_ of \_\_\_\_\_  
(Name of plat or addition)

County of \_\_\_\_\_  
(If within city or town, give name)

3. Construction Work was begun on UNKNOWN (Date); was completed on UNKNOWN (Date)

and the ground water claimed was first used for the purposes set out below on 1941 (Date)

since which time the water has been used INTERMITTENTLY  
(Continuously or intermittently)

from 1940 (Date) to 1957 (Date)

4. Quantity of water claimed and used is 800 gallons per minute \_\_\_\_\_ acre feet per year.

5. Purpose or Purposes for which water is used IRRIGATION

(Domestic, irrigation, municipal, manufacturing, industrial, etc.)

6. Description of Well: Depth 35 feet. Type DRIILLED  
(Dug or drilled)

diameter 10 inches. Elevation of ground at well site 160 feet, mean sea level.  
(As near as known)

Depth to water table 10 feet.

7. Capacity of Well: \_\_\_\_\_ g.p.m. with \_\_\_\_\_ feet drawdown.

\_\_\_\_\_ g.p.m. with \_\_\_\_\_ feet drawdown.

Date of test \_\_\_\_\_

If Flowing Well: Measured discharge \_\_\_\_\_ g.p.m. on \_\_\_\_\_  
(Date)


Shut-in pressure at ground surface \_\_\_\_\_ lbs. per sq. in. on \_\_\_\_\_  
(Date)

Water is controlled by \_\_\_\_\_  
(Cap, valve, etc.)





Township 9 S. Range 4 W., W.M.  
North

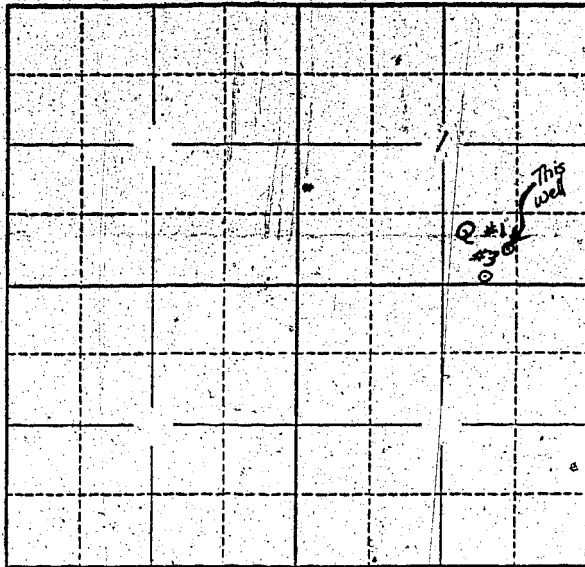

Locate well and acreage of irrigated land on plat.  
Scale: 2" = 1 Mile

STATE OF OREGON

County of Polk } ss.

I, \_\_\_\_\_, being first duly sworn, do hereby certify that I have read the foregoing Registration Statement and that all of the items therein contained are true to the best of my knowledge and belief.

Alfred M. Hansen  
(Signature of Registrant)

Subscribed and sworn to before me this 10 day of June, 1958

My commission expires MY COMMISSION EXPIRES MAY 25, 1960

A. M. Coleman  
(Notary Public)

(SEAL)

### CERTIFICATE OF REGISTRATION

STATE OF OREGON

County of Marion } ss.

This is to certify that the foregoing Registration Statement was received in the office of the State Engineer on the 10th day of June, 1958, at 11:00 o'clock A. M. and has been duly recorded in said office in Book No. 8 of Registration Statements on page GR-1646

Witness my hand this 7th day of January, 1959

Lewis A. Stanley  
(State Engineer)

By \_\_\_\_\_  
(Deputy)

\$15.00

GR-1646