

Registration Statement

OF CLAIMANT OF RIGHT TO APPROPRIATE GROUND WATER

TO THE STATE ENGINEER OF OREGON:

I, ALFRED M. HAENER

of INDEPENDENCE RT 1 BOX 37 County of POLK

State of OREGON, do hereby make application for a certificate of registration as evidence of a right to appropriate ground water.

1. Source from which water is withdrawn is PUMP WELL #3

2. Location is: 7 MILES SOUTHEAST OF INDEPENDENCE, OR.

and is more particularly described as follows: OF SECTION 1

(a) 1876 FEET W. AND 43 FEET N. OF S.E. CORNER

being within N.W. & S.W. 1/4 OF THE S.E. 1/4 of Sec. 1, Twp. 9 S., Rge. 4 W.

or (b) within limits of recorded platted property, town or city:

in Lot _____, Block _____ of _____ County of _____

3. Construction Work was begun on UNKNOWN; was completed on 1941

and the ground water claimed was first used for the purposes set out below on 1941

since which time the water has been used INTERMITTENTLY from 1941 to 1941

4. Quantity of water claimed and used is _____ gallons per minute; _____ acre feet per year.

5. Purpose or Purposes for which water is used IRRIGATION

6. Description of Well: Depth 31 feet. Type DRILLED

diameter _____ inches. Elevation of ground at well site 16 feet, mean sea level. Depth to water table _____ feet.

7. Capacity of Well: _____ g.p.m. with _____ feet drawdown. _____ g.p.m. with _____ feet drawdown.


Date of test _____

If Flowing Well: Measured discharge _____ g.p.m. on _____

Shut-in pressure at ground surface _____ lbs. per sq. in. on _____

Water is controlled by _____

Township 9 S. Range 4 W., W.M.
North

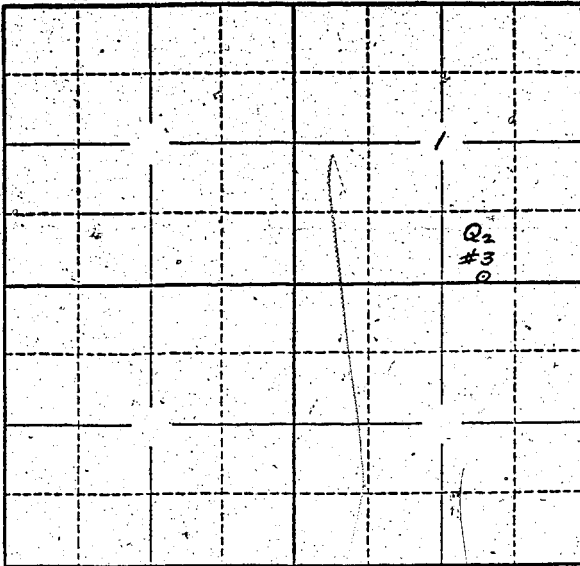

Locate well and acreage of irrigated land on plat.
Scale: 2" = 1 Mile

STATE OF OREGON }
County of Folk } ss.

I, _____, being first duly sworn, do hereby certify that I have read the foregoing Registration Statement and that all of the items therein contained are true to the best of my knowledge and belief.

Alfred M. Harris
(Signature of Registrant)

Subscribed and sworn to before me this 11 day of _____, 1959

My commission expires _____
NOTARY PUBLIC FOR OREGON
MY COMMISSION EXPIRES MAY 26, 1960

H.M. Blinn
(Notary Public)

(SEAL)

CERTIFICATE OF REGISTRATION

STATE OF OREGON }
County of Marion } ss.

This is to certify that the foregoing Registration Statement was received in the office of the State Engineer on the 10th day of June, 1959, at 11:00 o'clock A. M. and has been duly recorded in said office in Book No. 8 of Registration Statements on page GR-1648

Witness my hand this 7th day of January, 1959

Leona A. Stanley
(State Engineer)

\$15.00

By _____ (Deputy)