

# Registration Statement

**RECEIVED**

OF CLAIMANT OF RIGHT TO APPROPRIATE GROUND WATER

MAY 1 1956

(Under Chapter 708, Oregon Laws 1955.)

STATE ENGINEER  
SALEM, OREGON

**TO THE STATE ENGINEER OF OREGON:**

I, We Pearl F. and Ernest L. Pletzer RF1 Box 82 Turner

of Marion County of Marion

State of Oregon do hereby make application for a certificate of registration as evidence of a right to appropriate ground water.

1. Source from which water is withdrawn is well #1  
(Flowing well, pump well, infiltration trench, or tunnel)

2. Location is: 3 Miles South of Marion, Oregon  
(Approximate distance and direction from nearest city or town)

and is more particularly described as follows:

(a) 1968.83 feet North and 1487.82 feet West of the South-east  
(Give distance and bearing to corner of section or other legal subdivision)  
Corner of the William M<sup>c</sup> Kirney D.L.C. 4, Twp. 10 S., Rge. 2 W.  
being within S. W. 1 of S. W. 4 of Sec. 4, Twp. 10 S., Rge. 2 W.  
(Smallest legal subdivision) (N. or S.) (E. or W.)

or (b) within limits of recorded platted property, town or city:

in Lot \_\_\_\_\_, Block \_\_\_\_\_ of \_\_\_\_\_  
(Name of plat or addition)

County of \_\_\_\_\_  
(If within city or town, give name)

3. Construction Work was begun on 15 June 1941; was completed on 15 June 1941  
(Date) (Date)

and the ground water claimed was first used for the purposes set out below on 15 July 1941  
(Date)

since which time the water has been used Continuously  
(Continuously or intermittently)

from 15 July 1941 to to date  
(Date) (Date)

4. Quantity of water claimed and used is 500 ~~100~~ 300 ~~ft.~~ gallons per minute; 2.85 acre feet per year.

5. Purpose or Purposes for which water is used Irrigation of mint and row crops

(Domestic, irrigation, municipal, manufacturing, industrial, etc.)

6. Description of Well: Depth 30 feet. Type Drilled  
(Dug or drilled)

diameter 8" inches. Elevation of ground at well site 275.0 feet, mean sea level.  
(As near as known)

Depth to water table 13 feet.

7. Capacity of Well: 500 g.p.m. with 1 feet drawdown.

g.p.m. with \_\_\_\_\_ feet drawdown.

Date of test July 1956

If Flowing Well: Measured discharge \_\_\_\_\_ g.p.m. on \_\_\_\_\_  
(Date)

Shut-in pressure at ground surface \_\_\_\_\_ lbs. per sq. in. on \_\_\_\_\_  
(Date)

Water is controlled by \_\_\_\_\_  
(Cap, valve, etc.)



D E S C R I P T I O N

OF

P. F. & CHRISTEEN PLETZER PROPERTY.

Beginning at a point 39.53 chains South 40.55 chains East from the Northwest corner of Donation Land Claim of William Mc Kinney and wife in T. 10 S. R. 2 W. of the Willamette Meridian in Marion County, Oregon. Beginning point being S. E. corner of James A. Colgan's land; thence East 35.13 chains to S. W. corner of Clarence Roberts land; thence North 7.17 chains; thence West 13.95 chains; thence North 2.92 chains; thence North  $87^{\circ} 15'$  West 4.00 chains; thence North  $88^{\circ}$  West 4.00 chains; thence North  $70^{\circ}$  West 3.17 chains; thence North  $41^{\circ} 45'$  West 2.88 chains; thence North  $79^{\circ} 45'$  West 6.53 chains; thence South  $60^{\circ}$  West 4.25 chains; thence South  $89^{\circ} 45'$  East 2.19 chains; thence South  $0^{\circ} 15'$  East 12.89 chains to the place of beginning and containing 33 acres more or less.

D E S C R I P T I O N

OF

ERNEST L. PLETZER PROPERTY

Beginning at a point on the South line of the William Mc Kinney Donation Land Claim in T. 10 S. R. 2 W. of the Willamette Meridian in Marion County, Oregon; said point being 15.096 chains West of the S. E. corner of claim; thence West along the South line of said claim 28.444 chains; thence North  $3^{\circ} 35'$  West 25.0 chains; thence West 5.0 chains; thence North  $3^{\circ} 35'$  West 11.0 chains; thence East 17.01 chains; thence North 4.50 chains; thence East 11.20 chains to Easterly line of a county road; thence South  $0^{\circ} 24'$  East 15.318 chains; thence East 7.424 chains; thence south 25.058 chains; to beginning and containing 108.65 acres more or less.

D E S C R I P T I O N

OF

CHARLES GILBERT & ALICE D. PLETZER PROPERTY

Beginning at a point 39.53 chains South 40.55 chains East and 10.00 chains North  $0^{\circ} 15'$  West from the Northwest corner of Donation Land Claim of William Mc Kinney and wife in T. 10 S. R. 2 W. of the Willamette Meridian in Marion County, Oregon; thence North  $0^{\circ} 15'$  West 2.89 chains; thence North  $89^{\circ} 45'$  West 2.19 chains; thence North  $60^{\circ}$  East 4.25 chains; thence South  $79^{\circ} 45'$  East 6.53 chains; thence South  $41^{\circ} 45'$  East 2.88 chains; thence South  $70^{\circ}$  East .59 chains; thence South  $0^{\circ} 45'$  East 2.24 chains; thence Northwest 10.74 chains to beginning.

GR-161 A'

If log of well is not available, give name and address of driller.....

11. Infiltration Trench: Covered or open .....

Dimensions: Length ..... ft. Minimum depth ..... ft. Maximum depth ..... ft.

Bottom width ..... ft. Discharge ..... g.p.m. Date of test .....

12. Tunnel: Type of lining .....

Dimensions: .....  
(Length, course, and cross-sectional size)

Position of water bearing stratum with reference to portal of tunnel .....

Log of tunnel: (Preceding table for log of well may be used, if desired. Give footage from portal and character of materials, as pertinent.)

13. Pumping Equipment:

(a) Pump ..... Pacific Centrifugal 8" ..... Capacity 500 ..... g.p.m.  
(Make, type and size)

(b) Motor ..... 20 H. P. Electric .....  
(Type and horsepower)

14. Location of area irrigated or to be irrigated, or place of use if for purposes other than irrigation.


Township North or South	Range E. or W. of Willamette Meridian	Section	Forty-acre Tract	Number Acres To Be Irrigated	Date of Reclamation
<del>10 S</del>	<del>2 W</del>	<del>4</del>	<del>N. E. 1/4 of S. W. 1/4</del>	<del>4.25</del>	15 July 1941
<del>10 S</del>	<del>2 W</del>	<del>4</del>	<del>N. W. 1/4 of S. W. 1/4</del>	<del>5.52</del>	
10 S	2 W	4	S. W. 1/4 of S. W. 1/4	15.34 20.10	" "
<del>10 S</del>	<del>2 W</del>	<del>4</del>	<del>S. E. 1/4 of S. W. 1/4</del>	<del>22.75</del>	
<del>10 S</del>	<del>2 W</del>	<del>4</del>	<del>N. W. 1/4 of S. E. 1/4</del>	<del>.61</del>	
<del>10 S</del>	<del>2 W</del>	<del>4</del>	<del>S. W. 1/4 of S. E. 1/4</del>	<del>4.68</del>	
10 S	2 W	6	S. E. 1/4 of S. E. 1/4	14.17 14.17	" "
<del>10 S</del>	<del>2 W</del>	<del>8</del>	<del>N. E. 1/4 of N. E. 1/4</del>	<del>20.96</del>	
<del>10 S</del>	<del>2 W</del>	<del>8</del>	<del>S. E. 1/4 of N. E. 1/4</del>	<del>5.67</del>	
<del>10 S</del>	<del>2 W</del>	<del>9</del>	<del>N. W. 1/4 of N. W. 1/4</del>	<del>22.10</del>	
<del>10 S</del>	<del>2 W</del>	<del>9</del>	<del>S. W. 1/4 of N. W. 1/4</del>	<del>12.77</del>	
				29.51 142.60	

15. If the ground water supply is supplemental to an existing water supply, identification of any application for a permit, permit, certificate or adjudicated right to appropriate water made or held by the registrant.

This as an old well and will be tied in with 2 other wells the registration is filed herewith and a well which is being drilled. This permit application 6747 is filed herewith

GR-161 B

Township 10S Range 2W, W.M.  
North

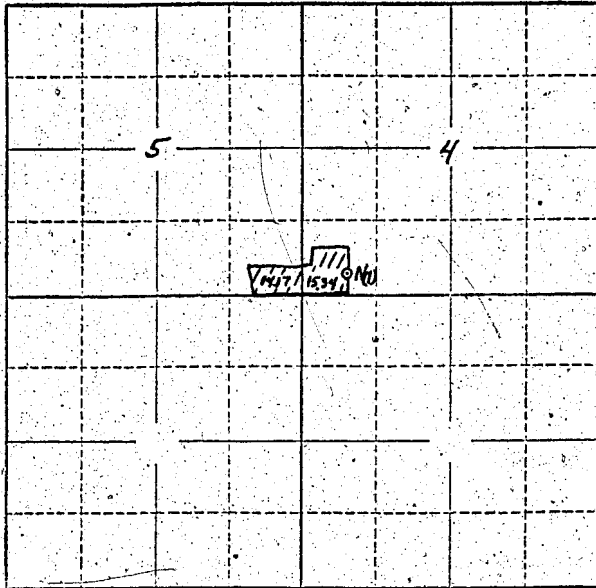

Locate well and acreage of irrigated land on plat.  
Scale: 2" = 1 Mile

STATE OF OREGON

County of Marion } ss.  
Pletzer L.

xx We Pearl F. and Ernest Pletzer being first duly sworn, do hereby certify that I have read the foregoing Registration Statement and that all of the items therein contained are true to the best of my knowledge and belief.

Pearl F. Pletzer

Ernest P. Pletzer  
(Signature of Registrant)

Subscribed and sworn to before me this 3rd day of May, 1956

My commission expires Sept. 25, 1958.

[Signature]  
(Notary Public)

(SEAL)

For Certificate See Page GR-161 K  
~~CERTIFICATE OF REGISTRATION~~

STATE OF OREGON } ss.  
County of Marion


Witness my hand this \_\_\_\_\_ day of \_\_\_\_\_, 19\_\_\_\_

(State Engineer)

By \_\_\_\_\_  
(Deputy)

GR-161 C

RECEIVED

Registration Statement

MAY 4 1956  
STATE ENGINEER  
SALEM, OREGON

OF CLAIMANT OF RIGHT TO APPROPRIATE GROUND WATER

(Under Chapter 708, Oregon Laws 1955.)

TO THE STATE ENGINEER OF OREGON:

I, K. We. Pearl F. and Ernest L. Pletzer  
of Marion County of Marion

State of Oregon, do hereby make application for a certificate of registration as evidence of a right to appropriate ground water.

1. Source from which water is withdrawn is Pump Well #2  
(Flowing well, pump well, infiltration trench, or tunnel)

2. Location is: 3 Miles South West  
(Approximate distance and direction from nearest city or town)

and is more particularly described as follows: 2016.34 feet West and 1087.00 feet North  
of the South East Corner of the William M<sup>c</sup> Kinney D. L. C. in T. 10 S. R. 2 W.

(a) NW 1/4 of NW 1/4  
(Give distance and bearing to corner of section or other legal subdivision)

being within Block #9 of Sec. 9, Twp. 10 S, Rge. 2 W  
(Smallest legal subdivision) (N. or S.) (E. or W.)

or (b) within limits of recorded platted property, town or city:

in Lot \_\_\_\_\_, Block \_\_\_\_\_ of \_\_\_\_\_  
(Name of plat or addition)

County of \_\_\_\_\_  
(If within city or town, give name)

3. Construction Work was begun on 1 May 1946; was completed on 15 May 1946  
(Date) (Date)

and the ground water claimed was first used for the purposes set out below on 15 July 1946  
(Date)

since which time the water has been used Continuously  
(Continuously or Intermittently)

from 15 July 1956 to \_\_\_\_\_ Date \_\_\_\_\_  
(Date) (Date)

4. Quantity of water claimed and used is 500 ~~1,700~~ Sec. Ft. gallons per minute; 285 acre feet per year.

5. Purpose or Purposes for which water is used irrigation of mint and row crops

(Domestic, irrigation, municipal, manufacturing, industrial, etc.)

6. Description of Well: Depth 30 feet. Type Drilled  
(Dug or drilled)

diameter 9" inches. Elevation of ground at well site 275 feet, mean sea level.  
(As near as known)

Depth to water table 13 feet.

7. Capacity of Well: 500 g.p.m. with 1 Ft. feet drawdown.

\_\_\_\_\_ g.p.m. with \_\_\_\_\_ feet drawdown.

Date of test 15 July 1946

If Flowing Well: Measured discharge \_\_\_\_\_ g.p.m. on \_\_\_\_\_  
(Date)

Shut-in pressure at ground surface \_\_\_\_\_ lbs. per sq. in. on \_\_\_\_\_  
(Date)

Water is controlled by \_\_\_\_\_  
(Cap, valve, etc.)

GR-161 D



If log of well is not available, give name and address of driller. ....

11. Infiltration Trench: Covered or open .....

Dimensions: Length ..... ft. Minimum depth ..... ft. Maximum depth ..... ft.

Bottom width ..... ft. Discharge ..... g.p.m. Date of test .....

12. Tunnel: Type of lining .....

Dimensions: .....  
(Length, course, and cross sectional size)

Position of water bearing stratum with reference to portal of tunnel .....

Log of tunnel: (Preceding table for log of well may be used, if desired. Give footage from portal and character of materials, as pertinent.)

13. Pumping Equipment:

(a) Pump Pacific Centrifugal 8' Capacity 500 g.p.m.  
(Make, type and size)

(b) Motor 20 H.P. Electric  
(Type and horsepower)


14. Location of area irrigated or to be irrigated, or place of use if for purposes other than irrigation.

Township North or South	Range E. or W. of Willamette Meridian	Section	Forty-acre Tract	Number Acres To Be Irrigated	Date of Reclamation
<del>10 S</del>	<del>2 W</del>	<del>4</del>	<del>N. E. 1/4 of S. W. 1/4</del>	<del>10.13</del>	<u>15 July 1946</u>
<del>10 S</del>	<del>2 W</del>	<del>4</del>	<del>N. W. 1/4 of S. W. 1/4</del>	<del>10.13</del>	
<del>10 S</del>	<del>2 W</del>	<del>4</del>	<del>S. N. 1/4 of S. W. 1/4</del>	<del>10.13</del>	
<del>10 S</del>	<del>2 W</del>	<del>4</del>	<del>S. S. 1/4 of S. W. 1/4</del>	<del>10.13</del>	
<del>10 S</del>	<del>2 W</del>	<del>4</del>	<del>N. W. 1/4 of S. E. 1/4</del>	<del>10.13</del>	
<del>10 S</del>	<del>2 W</del>	<del>4</del>	<del>S. W. 1/4 of S. E. 1/4</del>	<del>10.13</del>	
<del>10 S</del>	<del>2 W</del>	<del>5</del>	<del>S. E. 1/4 of S. E. 1/4</del>	<del>10.13</del>	
10 S	2 W	8	N. E. 1/4 of N. E. 1/4	20.98 ✓	"
10 S	2 W	8	S. E. 1/4 of N. E. 1/4	5.67 ✓	"
10 S	2 W	9	N. W. 1/4 of N. E. 1/4	38.15 ✓	"
10 S	2 W	9	S. W. 1/4 of N. E. 1/4	12.77 ✓	"
				<del>10.13</del>	
				<u>77.57</u>	<u>15 July 1946</u>

15. If the ground water supply is supplemental to an existing water supply, identification of any application for a permit, permit, certificate or adjudicated right to appropriate water made or held by the registrant. This is an old well and will be tied in with 2 other wells the registration of which is filed here-with and another new well the permit application is filed herewith.



Township 10 S Range 2 W, W.M.  
North

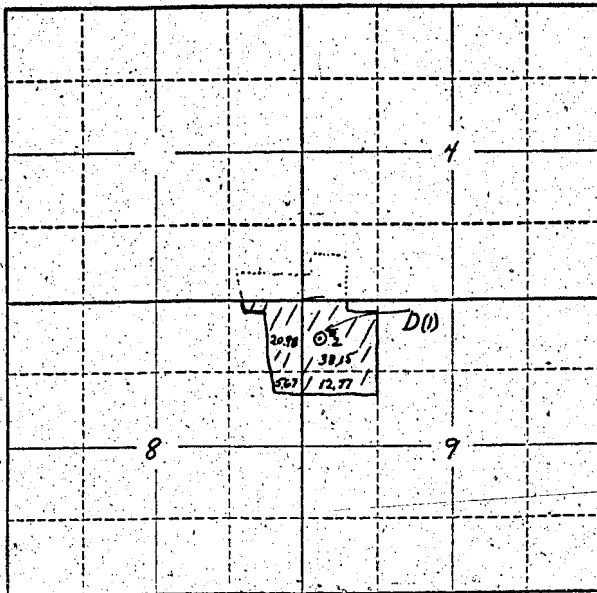

Locate well and acreage of irrigated land on plat.  
Scale: 2" = 1 Mile

STATE OF OREGON

County of Marion } ss.

I, Pletzer,

Pearl F. Pletzer and Ernest F. Pletzer, being first duly sworn, do hereby certify that I have read the foregoing Registration Statement and that all of the items therein contained are true to the best of my knowledge and belief.

Pearl F. Pletzer

Ernest F. Pletzer  
(Signature of Registrant)

Subscribed and sworn to before me this 3rd day of May, 1956

My commission expires Sept. 25, 1958

[Signature]  
(Notary Public)

(SEAL)

For Certificate See Page GR-161 K  
CERTIFICATE OF REGISTRATION

STATE OF OREGON

County of Marion } ss.


Witness my hand this \_\_\_\_\_ day of \_\_\_\_\_, 19\_\_\_\_

(State Engineer)

By \_\_\_\_\_  
(Deputy)

GR-161 G

Well No. 4

REGISTRATION NO. GR-170

CERTIFICATE NO. GR-161

RECEIVED

Registration Statement

MAY 1 1956  
STATE ENGINEER  
SALEM, OREGON

OF CLAIMANT OF RIGHT TO APPROPRIATE GROUND WATER

(Under Chapter 708, Oregon Laws 1955.)

TO THE STATE ENGINEER OF OREGON:

We Pearl F. and Ernest L. Pletzer

of Marion County of Marion

State of Oregon do hereby make application for a certificate of registration as evidence of a right to appropriate ground water.

- 1. Source from which water is withdrawn is Pump Well #4 (Flowing well, pump well, infiltration trench, or tunnel)
- 2. Location is: 3 Miles south of Marion Oregon (Approximate distance and direction from nearest city or town)

and is more particularly described as follows:

(a) North 21° 36' West 3204.84 feet from S.E. Cor. William McKinney D.L.C. (Give distance and bearing to corner of section or other legal subdivision)

being within S.W. 1/4 S.W. 1/4 of Sec. 4, Twp. 10, Rge. 2 W (Smallest legal subdivision) (N. or S.) (E. or W.)

or (b) within limits of recorded platted property, town or city:

in Lot Block of (Name of plat or addition)

County of (If within city or town, give name)

3. Construction Work was begun on 1 June 1939; was completed on 15 June 1939 (Date) (Date)

and the ground water claimed was first used for the purposes set out below on 15 June 1939 (Date)

since which time the water has been used Continuously (Continuously or intermittently)

from 15 June 1939 to Date (Date) (Date)

4. Quantity of water claimed and used is 500 ~~178~~ gallons per minute; 285 acre feet per year.

5. Purpose or Purposes for which water is used Irrigation of Mint and row crops (Domestic, irrigation, municipal, manufacturing, industrial, etc.)

6. Description of Well: Depth 30 feet. Type Drilled (Dug or drilled)

diameter 8" inches. Elevation of ground at well site 275 feet, mean sea level. (As near as known)

Depth to water table 13 feet.

7. Capacity of Well: 350 g.p.m. with No feet drawdown. g.p.m. with feet drawdown.

Date of test 15 June 1939

If Flowing Well: Measured discharge g.p.m. on (Date)

Shut-in pressure at ground surface lbs. per sq. in. on (Date)

Water is controlled by (Cap, valve, etc.)

GR-161 H



If log of well is not available, give name and address of driller. ....

11. Infiltration Trench: Covered or open .....

Dimensions: Length ..... ft. Minimum depth ..... ft. Maximum depth ..... ft.

Bottom width ..... ft. Discharge ..... g.p.m. Date of test .....

12. Tunnel: Type of lining .....

Dimensions: .....  
(Length, course, and cross sectional size)

Position of water bearing stratum with reference to portal of tunnel .....

Log of tunnel: (Preceding table for log of well may be used, if desired. Give footage from portal and character of materials, as pertinent.)

13. Pumping Equipment:

(a) Pump Pacific Centrifugal 15 H.P. 3" Capacity 350 g.p.m.  
(Make, type and size)

(b) Motor Electric 15 H.P.  
(Type and horsepower)

14. Location of area irrigated or to be irrigated, or place of use if for purposes other than irrigation.

Township North or South	Range E or W of Willamette Meridian	Section	Forty-acre Tract	Number Acres To Be Irrigated	Date of Reclamation
10 S	2 W	4	N.E. $\frac{1}{4}$ of S.W. $\frac{1}{4}$	6.12	15 June 1939
10 S	2 W	4	N.W. $\frac{1}{4}$ of S.W. $\frac{1}{4}$	6.52	
10 S	2 W	4	S.W. $\frac{1}{4}$ of S.W. $\frac{1}{4}$	<del>4.84</del> 20.10	
10 S	2 W	4	S.E. $\frac{1}{4}$ of S.W. $\frac{1}{4}$	12.75	
10 S	2 W	4	N.W. $\frac{1}{4}$ of S.E. $\frac{1}{4}$	.51	
10 S	2 W	4	S.W. $\frac{1}{4}$ of S.E. $\frac{1}{4}$	4.68	
<del>10 S</del>	<del>2 W</del>	<del>5</del>	<del>S.E. <math>\frac{1}{4}</math> of S.E. <math>\frac{1}{4}</math></del>	<del>14.17</del>	
<del>10 S</del>	<del>2 W</del>	<del>8</del>	<del>N.E. <math>\frac{1}{4}</math> of N.E. <math>\frac{1}{4}</math></del>	<del>20.90</del>	
<del>10 S</del>	<del>2 W</del>	<del>9</del>	<del>S.E. <math>\frac{1}{4}</math> of N.E. <math>\frac{1}{4}</math></del>	<del>5.67</del>	
<del>10 S</del>	<del>2 W</del>	<del>9</del>	<del>N.W. <math>\frac{1}{4}</math> of N.W. <math>\frac{1}{4}</math></del>	<del>38.15</del>	
<del>10 S</del>	<del>2 W</del>	<del>9</del>	<del>S.W. <math>\frac{1}{4}</math> of N.W. <math>\frac{1}{4}</math></del>	<del>12.77</del>	
				<del>112.50</del>	
				35.42	15 June 1939


15. If the ground water supply is supplemental to an existing water supply, identification of any application for a permit, permit, certificate or adjudicated right to appropriate water made or held by the registrant.

This is one of our wells used in a system. Other applications  
filed here with .....

GR-161 J

Township 10S Range 2W, W.M.

North

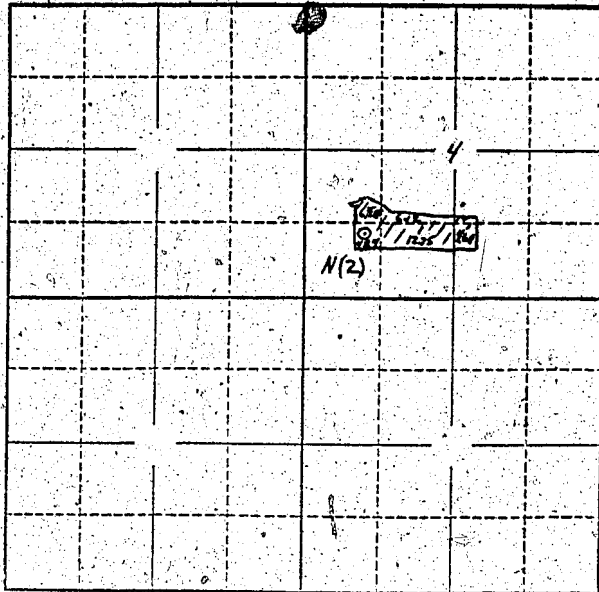

Locate well and acreage of irrigated land on plat.

Scale: 2" = 1 Mile

STATE OF OREGON

County of Marion

L. Pletzer,

being first duly sworn, do hereby certify that I have read the foregoing Registration Statement and that all of the items therein contained are true to the best of my knowledge and belief.

Pearl F. Pletzer

Ernest L. Pletzer  
(Signature of Registrant)

Subscribed and sworn to before me this 3rd day of May, 1956.

My commission expires Sept. 25, 1958

Renewal  
(Notary Public)

(SEAL)

**CERTIFICATE OF REGISTRATION**

STATE OF OREGON

County of Marion

This is to certify that the foregoing Registration Statement was received in the office of the State Engineer on the 5th day of April, 1956, at 12:45 o'clock P.M. and has been duly recorded in said office in Book No. 1 of Registration Statements on page GR-161 K

~~\_\_\_\_\_~~

~~\_\_\_\_\_~~

Witness my hand this 8th day of October, 1956

Lewis A. Stanley  
(State Engineer)

By \_\_\_\_\_  
(Deputy)

GR-161 K