

Registration Statement

OF CLAIMANT OF RIGHT TO APPROPRIATE GROUND WATER

TO THE STATE ENGINEER OF OREGON:

I, William Heilman
 of Rte 1 Box 213 Brooks County of Marion
(Mailing address)
 State of Oregon do hereby make application for a certificate of registration as evidence
 of a right to appropriate ground water.

1. Source from which water is withdrawn is Pump Well
(Flowing well, pump well, infiltration trench, or tunnel)
 2. Location is: Two miles East of Brooks
(Approximate distance and direction from nearest city or town)

and is more particularly described as follows:

(a) 250 feet north & 50 feet east from the SW corner Sec 15
(Give distance and bearing to corner of section or other legal subdivision)
 being within SW 1/4 of SE 1/4 of Sec 15, Twp. 6S, Rge. 2W
(Smallest legal subdivision) (N. or S.) (E. or W.)

or (b) within limits of recorded platted property, town or city:

in Lot _____, Block _____ of _____
(Name of plat or addition)

County of _____
(If within city or town, give name)

3. Construction Work was begun on June 5, 1950; was completed on June 12, 1950
(Date) (Date)
 and the ground water claimed was first used for the purposes set out below on June 18, 1950
(Date)
 since which time the water has been used intermittently during season
(Continuously or intermittently)
 from 1950 to 1957
(Date) (Date)

4. Quantity of water claimed and used is 130 gallons per minute; _____ acre
 feet per year.

5. Purpose or Purposes for which water is used Irrigation

(Domestic, irrigation, municipal, manufacturing, industrial, etc.)

6. Description of Well: Depth 53 feet. Type Drilled
(Dug or drilled)
 diameter 8 inches. Elevation of ground at well site 100 feet, mean sea level.
(As near as known)
 Depth to water table 8 feet.

7. Capacity of Well: 16 test g.p.m. with _____ feet drawdown.

_____ g.p.m. with _____ feet drawdown.

Date of test _____

If Flowing Well: Measured discharge _____ g.p.m. on _____
(Date)

Shut-in pressure at ground surface _____ lbs. per sq. in. on _____
(Date)

Water is controlled by _____
(Cap, valve, etc.)

8 inch diameter steel casing from 0 to 53 feet

inch diameter from to feet

inch diameter from to feet

inch diameter from to feet

Describe and show depth of shoe, plug, adapter, liner or other details: _____

Mills Knife - slots

(Number per foot and size of perforations, or describe screen)

from 40 to 50

from to

from to

from to

10. **Log of Well:** (Describe each stratum or formation clearly, indicate if water bearing, and give thickness and depth as indicated.)

[illegible]

If log of well is not available, give name and address of driller.

D. L. Clement, Gervais, Oregon

11. Infiltration Trench: Covered or open

Dimensions: Length ft. Minimum depth ft. Maximum depth ft.

Bottom width ft. Discharge g.p.m. Date of test

12. Tunnel: Type of lining

Dimensions: _____
(Length, course, and cross sectional size)

Position of water bearing stratum with reference to portal of tunnel

Log of tunnel: (Preceding table for log of well may be used, if desired. Give footage from portal and character of materials, as pertinent.)

13. Pumping Equipment:

(a) Pump, Turbine Capacity 175 g.p.m.
(Make, type and size)


(b) Motor 9 H.P. Gas engine
(Type and horsepower)

14. Location of area irrigated or to be irrigated, or place of use if for purposes other than irrigation.

[illegible]

15. If the ground water supply is supplemental to an existing water supply, identification of any application for a permit, permit, certificate or adjudicated right to appropriate water made or held by the registrant.

Township 6S Range 2W, W.M.
North

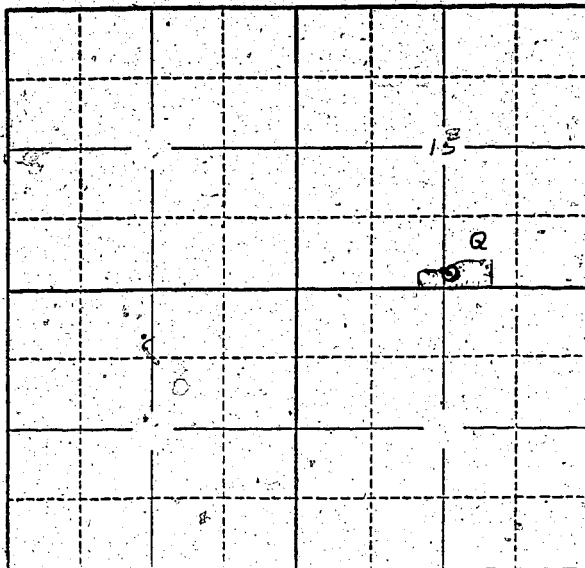

Locate well and acreage of irrigated land on plat.
Scale: 2" = 1 Mile

STATE OF OREGON

County of Marion } ss.

I, Mrs Wm Heilman, being first duly sworn, do hereby certify that I have read the foregoing Registration Statement and that all of the items therein contained are true to the best of my knowledge and belief.

Mrs Wm Heilman
(Signature of Registrant)

Subscribed and sworn to before me this 10th day of June, 1958

My commission expires 12th June 1961 Wm. S. Bartholomew
(Notary Public)

(SEAL)

CERTIFICATE OF REGISTRATION

STATE OF OREGON

County of Marion } ss.

This is to certify that the foregoing Registration Statement was received in the office of the State Engineer on the 10th day of June, 1958, at 12⁰⁰ o'clock A.M. and has been duly recorded in said office in Book No. 8 of Registration Statements on page GR 1619

Witness my hand this 7th day of January, 1959

Lewis A. Stanley
(State Engineer)

By _____
(Deputy)

GR - 1649