

RECEIVED
JUN 17 1958
STATE ENGINEER
SALEM, OREGON

Registration No. GR 1703
Certificate No. GR 1652

Registration Statement

OF CLAIMANT OF RIGHT TO APPROPRIATE GROUND WATER

TO THE STATE ENGINEER OF OREGON:

I, J. H. Lyon

of Rt. 2, Box 108, Albany County of Linn
(Mailing address)

State of Oregon, do hereby make application for a certificate of registration as evidence of a right to appropriate ground water.

1. Source from which water is withdrawn is pump well
(Flowing well, pump well, infiltration trench, or tunnel)
2. Location is: 3 1/2 miles west of Jefferson, Oregon
(Approximate distance and direction from nearest city or town)

and is more particularly described as follows:

(a) 660' North and 3820' East of SW corner S. 16, T. 10 S., R. 3 W.
(Give distance and bearing to corner of section or other legal subdivision)

being within SW 1/4 of SE 1/4 of Sec. 16, Twp. 10 S, Rge. 3 W
(Smallest legal subdivision) (S. or S.) (E. or W.)

or (b) within limits of recorded platted property, town or city:

in Lot _____, Block _____ of _____
(Name of plat or addition)

County of Linn
(If within city or town, give name)

3. Construction Work was begun on 1951; was completed on 1951
(Date) (Date)

and the ground water claimed was first used for the purposes set out below on 1953
(Date)

since which time the water has been used continuously
(Continuously or intermittently)

from 1953 to present time
(Date) (Date)

4. Quantity of water claimed and used is 30 gallons per minute; 10.0 acre feet per year.

5. Purpose or Purposes for which water is used Irrigation

(Domestic, irrigation, municipal, manufacturing, industrial, etc.)

6. Description of Well: Depth 30 feet. Type Drilled
(Dug or drilled)

diameter 6 inches. Elevation of ground at well site 220 feet, mean sea level.
(As near as known)

Depth to water table 10 feet.

7. Capacity of Well: _____ g.p.m. with _____ feet drawdown.

_____ g.p.m. with _____ feet drawdown.


Date of test Not tested

If Flowing Well: Measured discharge _____ g.p.m. on _____
(Date)

Shut-in pressure at ground surface _____ lbs. per sq. in. on _____
(Date)

Water is controlled by _____
(Cap, valve, etc.)

Township 10 S Range 3 W W.M.
North

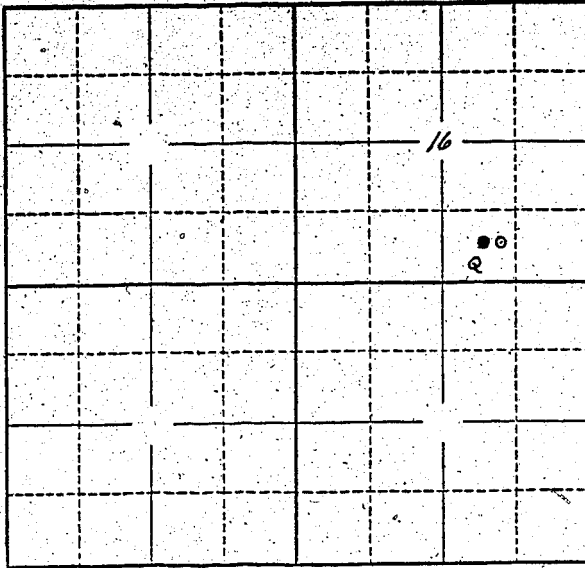

Locate well and acreage of irrigated land on plat.
Scale: 2" = 1 Mile

STATE OF OREGON }
County of LINN } ss.

I, J. H. Lyon, being first duly sworn, do hereby certify that I have read the foregoing Registration Statement and that all of the items therein contained are true to the best of my knowledge and belief.

J. H. Lyon
(Signature of Registrant)

Subscribed and sworn to before me this 9 day of June, 1952

My commission expires _____

Marvin A. Hutchings
(Notary Public)

(SEAL)

Justice of the Peace
Jefferson Dist. County of Marion
Jefferson Co.

CERTIFICATE OF REGISTRATION

STATE OF OREGON }
County of Marion } ss.

This is to certify that the foregoing Registration Statement was received in the office of the State Engineer on the 11th day of June, 1952, at 8:00 o'clock A.M. and has been duly recorded in said office in Book No. 8 of Registration Statements on page GR-1652

Witness my hand this 7th day of January, 1959

Lewis A. Stanley
(State Engineer)

#1500

By _____ (Deputy)

GR -1652