

Registration Statement

OF CLAIMANT OF RIGHT TO APPROPRIATE GROUND WATER

TO THE STATE ENGINEER OF OREGON:

I, Les W. and Lucile C. Foster

of Halsey County of Linn

State of Oregon, do hereby make application for a certificate of registration as evidence of a right to appropriate ground water.

1. Source from which water is withdrawn is pump well
(Flowing well, pump well, infiltration trench, or tunnel)

2. Location is: 4 1/2 miles south of Halsey, Oregon
(Approximate distance and direction from nearest city or town)

and is more particularly described as follows:

(a) N. 36° 10' E. 11.5 chains from SW corner of NW 1/4 of S. 25, T. 14 S., R. 4 W.
(Give distance and bearing to corner of section or other legal subdivision)

being within SW 1/4 of NW 1/4 of Sec. 25, Twp. 14 S., Rge. 4 W.
(Smallest legal subdivision) (N. or S.) (E. or W.)

or (b) within limits of recorded platted property, town or city:
in Lot _____, Block _____ of _____
(Name of plat or addition)

County of Linn
(If within city or town, give name)

3. Construction Work was begun on June 1938; was completed on June 9, 1938
(Date) (Date)

and the ground water claimed was first used for the purposes set out below on July 1938
(Date)

since which time the water has been used continuously
(Continuously or intermittently)

from July 1938 to end of 1950 season, but will use again
(Date) (Date)

4. Quantity of water claimed and used is 90 gallons per minute; 51.25 acre
feet per year.

5. Purpose or Purposes for which water is used Irrigation

(Domestic, irrigation, municipal, manufacturing, industrial, etc.)

6. Description of Well: Depth 37 feet. Type Drilled
(Dug or drilled)

diameter 8 inches. Elevation of ground at well site 290 feet, mean sea level.
(As near as known)

Depth to water table 8 feet.

7. Capacity of Well: 90 g.p.m. with 12 feet drawdown.

_____ g.p.m. with _____ feet drawdown.

Date of test 1938

If Flowing Well: Measured discharge _____ g.p.m. on _____
(Date)

Shut-in pressure at ground surface _____ lbs. per sq. in. on _____
(Date)

Water is controlled by _____
(Cap, valve, etc.)

8. Casing: (Give diameter, commercial specifications and depth below ground surface of each casing size.)

8 inch diameter steel casing from 0 to 48 feet
 inch diameter from to feet
 inch diameter from to feet
 inch diameter from to feet

Describe and show depth of shoe, plug, adapter, liner or other details:

9. Perforated Casings or Screens:

Slot perforations - 2 rows from 20 to 30
(Number per foot and size of perforations, or describe screen)
 Slot perforations - 5 rows from 30 to 48
 from to
 from to

10. Log of Well: (Describe each stratum or formation clearly, indicate if water bearing, and give thickness and depth as indicated.)

MATERIAL	Thickness (Feet)	Depth to Bottom (Feet)
Clay	10	10
Cement gravel	10	20
Water bearing gravel	2	22
Cement gravel	14	36
Water bearing gravel	12	48

If log of well is not available, give name and address of driller.

11. Infiltration Trench: Covered or open

Dimensions: Length ft. Minimum depth ft. Maximum depth ft.

Bottom width ft. Discharge g.p.m. Date of test

12. Tunnel: Type of lining

Dimensions:
(Length, course, and cross sectional size)

Position of water bearing stratum with reference to portal of tunnel

Log of tunnel: (Preceding table for log of well may be used, if desired. Give footage from portal and character of materials, as pertinent.)

13. Pumping Equipment:

(a) Pump Pacific 2nd centrifugal Capacity 90 g.p.m.
(Make, type and size)

(b) Motor 5 H. P. electric
(Type and horsepower)

14. Location of area irrigated or to be irrigated, or place of use if for purposes other than irrigation.


Township North or South	Range E. or W. of Willamette Meridian	Section	Forty-acre Tract	Number Acres To Be Irrigated	Date of Reclamation
14 S	R 4 W	25	SW $\frac{1}{4}$ of NW $\frac{1}{4}$	20.5	July 1938

165-427 Foster

The South half of the Northwest quarter and the North half of the Southwest quarter of Sec. 25 in T. 14 S., R. 4 W. of the Will. Mer., also the South half of the 6 acre tract described as: Commencing 80 rods South of the Northeast corner of Section 26, T. 14 S., R. 4 W. of the Will. Mer.; and running thence West 7.26 chains; thence South 7.26 chains; thence East 7.26 chains; thence North 7.26 chains to the place of beginning.

15. If the ground water supply is supplemental to an existing water supply, identification of any application for a permit, permit, certificate or adjudicated right to appropriate water made or held by the registrant.

Township 14 S Range 4 W, W.M.
North

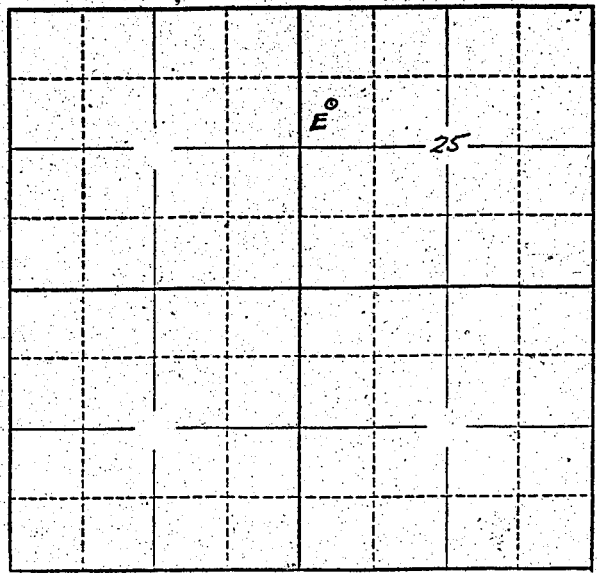

Locate well and acreage of irrigated land on plat.
Scale: 2" = 1 Mile

STATE OF OREGON }
County of LINN } ss.

I, Lee W. and Lucile Foster, being first duly sworn, do hereby certify that I have read the foregoing Registration Statement and that all of the items therein contained are true to the best of my knowledge and belief.

Lucile C Foster
Lee W Foster
(Signature of Registrant)

Subscribed and sworn to before me this 29 day of May, 1958.

My commission expires 8-10-59
Ray W. [Signature]
(Notary Public)

(SEAL)

CERTIFICATE OF REGISTRATION

STATE OF OREGON }
County of Marion } ss.

This is to certify that the foregoing Registration Statement was received in the office of the State Engineer on the 12th day of June, 1958, at 8:00 o'clock A. M. and has been duly recorded in said office in Book No. 8 of Registration Statements on page GR-1658

Witness my hand this 7th day of January, 1959.

Henry A. Stanley
(State Engineer)

\$ 15.00

By _____ (Deputy)

GR - 1658