

RECEIVED
STATE ENGINEER
SALE OF OREGON

Registration No. GR - 1710
Certificate No. GR - 1659

Registration Statement

OF CLAIMANT OF RIGHT TO APPROPRIATE GROUND WATER

TO THE STATE ENGINEER OF OREGON:

I, Darrell Jones

of RT-1-Box 44-B, Seaside Oregon County of Columbia

State of Oregon, do hereby make application for a certificate of registration as evidence of a right to appropriate ground water.

1. Source from which water is withdrawn is Pump well
(Flowing well, pump well, infiltration trench, or tunnel)

2. Location is: 2 mi. South of Seaside
(Approximate distance and direction from nearest city or town)

and is more particularly described as follows:

(a) 1250 feet north & 75 feet east from S 1/4 corner Section 24
(Give distance and bearing to corner of section or other legal subdivision)

being within SW 1/4 of SE 1/4 of Sec. 24, Twp. 3-N, Rge. 2-W
(Smallest legal subdivision) (N. or S.) (E. or W.)

or (b) within limits of recorded platted property, town or city:

in Lot 20-1, Block _____ of Jackson Pl.
(Name of plat or addition)
County of Columbia
(If within city or town, give name)

3. Construction Work was begun on Sept. 25th 1952, was completed on Feb. 28th 1953
(Date) (Date)

and the ground water claimed was first used for the purposes set out below on June 1953
(Date)

since which time the water has been used Domestic & Irrigation
(Continuously or intermittently)
from March to October 1st - each year
(Date) (Date)

4. Quantity of water claimed and used is 13 gallons per minute; 7 1/2 acre feet per year.

5. Purpose or Purposes for which water is used Domestic & irrigation
Nursery stock
(Domestic, irrigation, municipal, manufacturing, industrial, etc.)

6. Description of Well: Depth 64 feet. Type Drilled
(Dug or drilled)
diameter 6 inches. Elevation of ground at well site 35 feet; mean sea level.
(As near as known)
Depth to water table 36 feet.

7. Capacity of Well: _____ g.p.m. with _____ feet drawdown.
_____ g.p.m. with _____ feet drawdown.


Date of test NO TEST

If Flowing Well: Measured discharge _____ g.p.m. on _____
(Date)

Shut-in pressure at ground surface _____ lbs. per sq. in. on _____
(Date)

Water is controlled by _____
(Cap. valve, etc.)

Township 3N Range 2W, W.M.
North

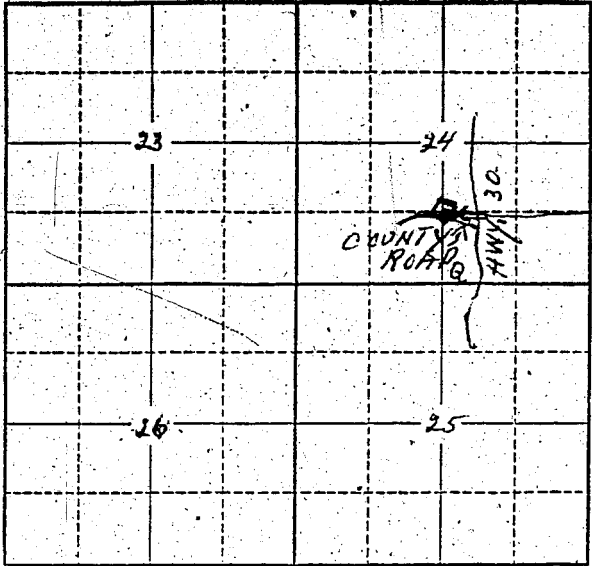

WELL IN SOUTH
EAST CORNER
2-ACRES

Locate well and acreage of irrigated land on plat.
Scale: 2" = 1 Mile

STATE OF OREGON }
County of Columbia } ss.

I, Darrell Jones, being first duly sworn, do hereby certify that I have read the foregoing Registration Statement and that all of the items therein contained are true to the best of my knowledge and belief.

Darrell Jones
(Signature of Registrant)

Subscribed and sworn to before me this 10th day of June, 1958.

My commission expires January 14, 1962

Dean J. Stoff
(Notary Public)

(SEAL)

CERTIFICATE OF REGISTRATION

STATE OF OREGON }
County of Marion } ss.

This is to certify that the foregoing Registration Statement was received in the office of the State Engineer on the 12th day of June, 1958, at 8:00 o'clock A. M. and has been duly recorded in said office in Book No. 8 of Registration Statements on page GR-1659

Witness my hand this 7th day of January, 1959

Lawrence A. Stanley
(State Engineer)

By _____ (Deputy)

#15.00

GR - 1659