

RECEIVED
JUN 11 1958
STATE ENGINEER
SALEM OREGON

Registration No. GR. [redacted]
Certificate No. GR - 1660

Registration Statement

OF CLAIMANT OF RIGHT TO APPROPRIATE GROUND WATER

TO THE STATE ENGINEER OF OREGON:

I, Harry and David, an Oregon Corporation
of P. O. Box 712, Medford County of Jackson
State of Oregon, do hereby make application for a certificate of registration as evidence
of a right to appropriate ground water.

1. Source from which water is withdrawn is Pump Well and Tunnel
(Flowing well, pump well, infiltration trench, or tunnel)
2. Location is: 2 miles South of Medford, Oregon
(Approximate distance and direction from nearest city or town)

and is more particularly described as follows:

(a) 90 feet South and 1160 feet East from SW corner DLC #54
(Give distance and bearing to corner of section or other legal subdivision)
being within NW $\frac{1}{4}$, NE $\frac{1}{4}$ of Sec. 6, Twp. 38 S., Rge. 1 W.
(Smallest legal subdivision) (N. or S.) (E. or W.)
or (b) within limits of recorded platted property, town or city:
in Lot _____, Block _____ of _____
(Name of plat or addition)
County of _____
(If within city or town, give name)

3. Construction Work was begun on prior to 1900; was completed on 1937
(Date) (Date)
and the ground water claimed was first used for the purposes set out below on prior to 1900
(Date)
since which time the water has been used intermittently
(Continuously or intermittently)
from 1900 to present
(Date) (Date)

4. Quantity of water claimed and used is 50 gallons per minute; -- acre feet per year.

5. Purpose or Purposes for which water is used manufacturing and domestic (including cold storage water, water for domestic and manufacturing in all plant and office buildings, orchard spraying, etc.)
(Domestic, irrigation, municipal, manufacturing, industrial, etc.)

6. Description of Well: Depth 30 feet. Type dug
(Dug or drilled)
diameter 36 inches. Elevation of ground at well site 1110 feet, mean sea level.
(As near as known)
Depth to water table 12 feet.

7. Capacity of Well: 50 g.p.m. with 28 feet drawdown.
_____ g.p.m. with _____ feet drawdown.


Date of test 15 September 1957

If Flowing Well: Measured discharge _____ g.p.m. on _____
(Date)

Shut-in pressure at ground surface _____ lbs. per sq. in. on _____
(Date)

Water is controlled by _____
(Cap, valve, etc.)

Township 385 Range 1W, W.M.
North

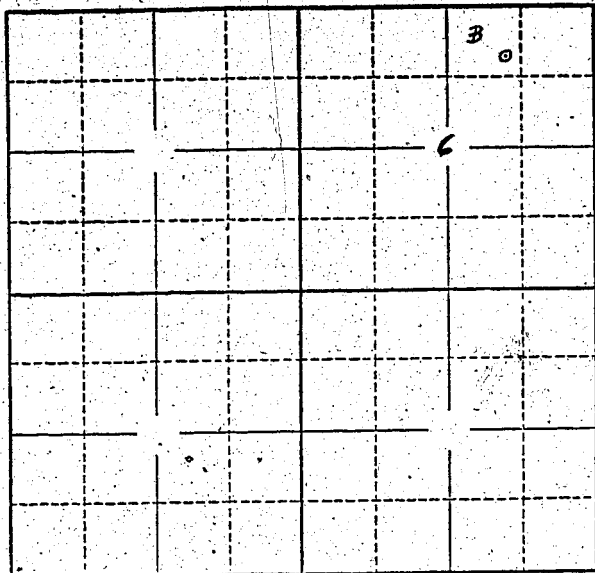

Locate well and acreage of irrigated land on plat.
Scale: 2" = 1 Mile

STATE OF OREGON }
County of Jackson } ss.

I, G. A. Cottingham, being first duly sworn, do hereby certify that I have read the foregoing Registration Statement and that all of the items therein contained are true to the best of my knowledge and belief.

HARRY and DAVID
By: G. A. Cottingham Secy-Treas.
(Signature of Registrant)

Subscribed and sworn to before me this 6th day of June, 1958

My commission expires NOTARY PUBLIC FOR OREGON
(SEAL) My Commission Expires Feb. 8, 1961

G. W. Harrison
(Notary Public)

CERTIFICATE OF REGISTRATION

STATE OF OREGON }
County of Marion } ss.

This is to certify that the foregoing Registration Statement was received in the office of the State Engineer on the 12th day of June, 1958 at 8:00 o'clock A. M. and has been duly recorded in said office in Book No. 8 of Registration Statements on page GR-1660

Witness my hand this 7th day of January, 1959

Henry A. Stanley
(State Engineer)

By _____ (Deputy)

\$ 20⁰⁰