

Registration Statement

OF CLAIMANT OF RIGHT TO APPROPRIATE GROUND WATER

TO THE STATE ENGINEER OF OREGON:

I, Harry and David, an Oregon Corporation

of P. O. Box 712, Medford, County of Jackson
(Mailing address) does

State of Oregon /do hereby make application for a certificate of registration as evidence of a right to appropriate ground water.

1. Source from which water is withdrawn is Pump Well and Tunnel
(Flowing well, pump well, infiltration trench, or tunnel)
2. Location is: 2 miles South of Medford, Oregon
(Approximate distance and direction from nearest city or town)

and is more particularly described as follows:

(a) 615 feet north and 2305 feet east from SW corner DLC #54
(Give distance and bearing to corner of section or other legal subdivision)

being within NE $\frac{1}{4}$ NE $\frac{1}{4}$ of Sec. 6, Twp. 38 S., Rge. 1 W.
(Smallest legal subdivision) (N. or S.) (E. or W.)

or (b) within limits of recorded platted property, town or city:

in Lot _____, Block _____ of _____
(Names of plat or addition)

County of _____
(If within city or town, give name)

3. Construction Work was begun on prior to 1900; was completed on 1924
(Date) (Date)

and the ground water claimed was first used for the purposes set out below on prior to 1900
(Date)

since which time the water has been used continuously
(Continuously or intermittently)

from prior to 1900 to present
(Date) (Date)

4. Quantity of water claimed and used is 80 gallons per minute; _____ acre feet per year.

5. Purpose or Purposes for which water is used manufacturing and domestic (including cold storage water, water for domestic and manufacturing in all plant and office buildings, orchard spraying, etc.)
(Domestic, irrigation, municipal, manufacturing, industrial, etc.)

6. Description of Well: Depth 30 feet. Type dug
(Dug or drilled)

diameter 96 inches. Elevation of ground at well site 1410 feet, mean sea level.
(As near as known)

Depth to water table 12 feet.

7. Capacity of Well: 80 g.p.m. with 28 feet drawdown.

_____ g.p.m. with _____ feet drawdown.

Date of test 15 September 1957

If Flowing Well: Measured discharge _____ g.p.m. on _____
(Date)

Shut-in pressure at ground surface _____ lbs. per sq. in. on _____
(Date)

Water is controlled by _____
(Cap. valve, etc.)

8. Casing: (Give diameter, commercial specifications and depth below ground surface of each casing size.)

none inch diameter from to feet
 inch diameter from to feet
 inch diameter from to feet
 inch diameter from to feet

Describe and show depth of shoe, plug, adapter, liner or other details:

none

9. Perforated Casings or Screens:

none (Number per foot and size of perforations, or describe screen) from to
 from to
 from to
 from to

10. Log of Well: (Describe each stratum or formation clearly, indicate if water bearing, and give thickness and depth as indicated.)

MATERIAL	Thickness (Feet)	Depth to Bottom (Feet)
none		

If log of well is not available, give name and address of driller. don't know

11. Infiltration Trench: Covered or open _____

Dimensions: Length _____ ft. Minimum depth _____ ft. Maximum depth _____ ft.

Bottom width _____ ft. Discharge _____ g.p.m. Date of test _____

12. Tunnel: Type of lining Unlined.

Dimensions: 100 feet long, 7' x 7', straight
(Length, course, and cross sectional size)

Position of water bearing stratum with reference to portal of tunnel don't know

Log of tunnel: (Preceding table for log of well may be used, if desired. Give footage from portal and character of materials, as pertinent.)

13. Pumping Equipment:

Demming reciprocating 5 1/2" x 5 1/2" 50 &

(a) Pump Meyers reciprocating 3" x 10" Capacity 30 g.p.m.

G.E. Electric 1 H.P. (Make, type and size)


(b) Motor G.E. Electric 1 1/2 H.P.
(Type and horsepower)

14. Location of area irrigated or to be irrigated, or place of use if for purposes other than irrigation.

Township North or South	Range E. or W. of Willamette Meridian	Section	Forty-acre Tract	Number Acres To Be Irrigated	Date of Reclamation
37 S.	1 W.	32	S 1/2 SW 1/4 SW 1/4	manufacturing domestic & etc.	prior to 1900
38 S.	1 W.	5	NE 1/4 NW 1/4	" " "	" " "
		5	NW 1/4 NW 1/4	" " "	" " "
37 S.	1 W.	31	SE 1/4 SE 1/4 SW 1/4	orchard spraying	" " "
		31	S 1/2 SW 1/4 SE 1/4	" "	" " "
		31	S 1/2 SE 1/4 SE 1/4	" "	" " "
		32	S 1/2 SW 1/4 SW 1/4	" "	" " "
38 S.	1 W.	5	NW 1/4	" " "	" " "
		5	W 1/2 W 1/2 SW 1/4 NE 1/4	" "	" " "
		5	NW 1/4 SW 1/4	" "	" " "
		6	E 1/2 E 1/2 NE 1/4 NW 1/4	" "	" " "
		6	NE 1/4	" "	" " "
		6	N 1/2 NE 1/4 SE 1/4	" "	" " "

15. If the ground water supply is supplemental to an existing water supply, identification of any application for a permit, permit, certificate or adjudicated right to appropriate water made or held by the registrant.
none

Township 38S Range 1W, W.M.
North

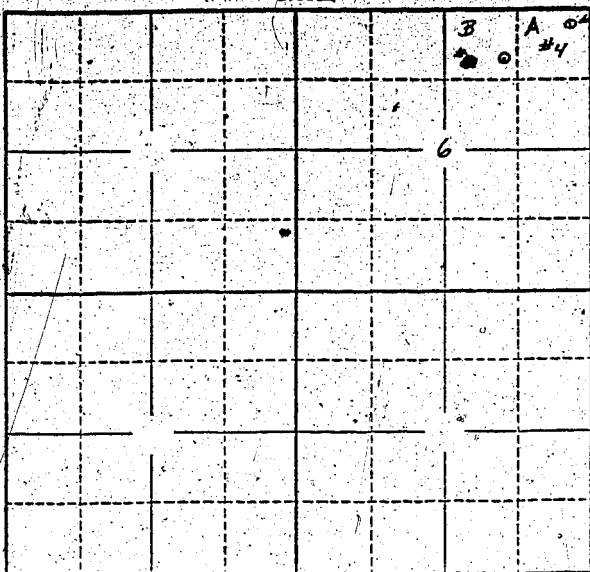

Locate well and acreage of irrigated land on plat.
Scale: 2" = 1 Mile

STATE OF OREGON }
County of Jackson } ss.

I, G. A. Cottingham, being first duly sworn, do hereby certify that I have read the foregoing Registration Statement and that all of the items therein contained are true to the best of my knowledge and belief.

HARRY and DAVID
By: [Signature] Secy-Treas.
(Signature of Registrant)

Subscribed and sworn to before me this 6th day of June, 1958.

My commission expires _____
[Signature]
(Notary Public)

(SEAL) NOTARY PUBLIC FOR OREGON
My Commission Expires Feb. 8, 1961

CERTIFICATE OF REGISTRATION

STATE OF OREGON }
County of Marion } ss.

This is to certify that the foregoing Registration Statement was received in the office of the State Engineer on the 12th day of June, 1958, at 8:00 o'clock A.M. and has been duly recorded in said office in Book No. 8 of Registration Statements on page GR-1661

Witness my hand this 7 day of January, 1959.

[Signature]
(State Engineer)

By _____
(Deputy)

20.00

GR - 1661