

Registration Statement

OF CLAIMANT OF RIGHT TO APPROPRIATE GROUND WATER

TO THE STATE ENGINEER OF OREGON:

T. Harry and David, an Oregon Corporation
of P. O. Box 712, Medford, County of Jackson
State of Oregon does hereby make application for a certificate of registration as evidence of a right to appropriate ground water.

1. Source from which water is withdrawn is Pump Well and Tiling
(Flowing well, pump well, infiltration trench, or tunnel)
2. Location is: 2 miles South of Medford, Oregon
(Approximate distance and direction from nearest city or town)

and is more particularly described as follows:

(a) 2230 feet North and 1150 feet East from the NE corner DIC #17
(Give distance and bearing to corner of section or other legal subdivision)
being within NE $\frac{1}{4}$ NW $\frac{1}{4}$ of Sec. 5, Twp. 38 S., Rge. 1 W.
(Smallest legal subdivision) (N. or S.) (E. or W.)
or (b) within limits of recorded platted property, town or city:
in Lot _____, Block _____ of _____
(Name of plat or addition)
County of _____
(If within city or town, give name)

3. Construction Work was begun on 1 May 1948; was completed on 1 August 1948
(Date) (Date)
and the ground water claimed was first used for the purposes set out below on 1 August 1948
(Date)
since which time the water has been used continuously
(Continuously or intermittently)
from 1 August 1948 to present
(Date) (Date)

4. Quantity of water claimed and used is 90 gallons per minute; _____ acre feet per year.

5. Purpose or Purposes for which water is used manufacturing and domestic (including cold storage water, water for domestic and manufacturing in all plant and office buildings, orchard spraying, etc.)
(Domestic, irrigation, municipal, manufacturing, industrial, etc.)

6. Description of Well: Depth 16 feet. Type Dug
(Dug or drilled)
diameter 36 inches. Elevation of ground at well site 1110 feet, mean sea level.
(As near as known)
Depth to water table 12 feet.

7. Capacity of Well: 90 g.p.m. with 16 feet drawdown.
_____ g.p.m. with _____ feet drawdown.

Date of test August - 1956

If Flowing Well: Measured discharge _____ g.p.m. on _____
(Date)

Shut-in pressure at ground surface _____ lbs. per sq. in. on _____
(Date)

Water is controlled by _____
(Cap. valve, etc.)

If log of well is not available, give name and address of driller. dug by Fred Sheffel

(Sheffel Construction Co.)

Tiled

11. Infiltration Trench: Covered or open covered

Dimensions: Length 25 ft. Minimum depth 16 ft. Maximum depth 16 ft.

Bottom width 2-3 ft. Discharge N/A g.p.m. Date of test N/A

12. Tunnel: Type of lining

Dimensions: _____
(Length, course, and cross sectional size)

Position of water bearing stratum with reference to portal of tunnel

Log of tunnel: (Preceding table for log of well may be used, if desired. Give footage from portal and character of materials, as pertinent.)

13. Pumping Equipment: _____ together or singly

(a) Pump 2-1 1/2" Berkley Centrifugal Pumps Capacity 90 g.p.m.
(Make, type and size)

(b) Motor 5 H.P. Belgium (no brand) Motor-electric.
(Type and horsepower)


14. Location of area irrigated or to be irrigated, or place of use if for purposes other than irrigation.

Township North or South	Range E. or W. of Williams Meridian	Section	Forty-acre Tract	Number Acres To Be Irrigated	Date of Reclamation
37 S.	1 W.	32	S 1/2 SW 1/4, SW 1/4	manufacturing domestic & etc.	1 August 1948
38 S.	1 W.	5	NE 1/4 NW 1/4	" " "	" " "
		5	NW 1/4 NW 1/4	" " "	" " "
37 S.	1 W.	31	SE 1/4 SE 1/4 SW 1/4	Orchard Spraying	" " "
		31	S 1/2 SW 1/4 SE 1/4	" " "	" " "
		31	S 1/2 SE 1/4 SE 1/4	" " "	" " "
		32	S 1/2 SW 1/4 SW 1/4	" " "	" " "
38 S.	1 W.	5	NW 1/4	" " "	" " "
		5	W 1/2 W 1/2 SW 1/4 NE 1/4	" " "	" " "
		5	NW 1/4 SW 1/4	" " "	" " "
		6	E 1/2 E 1/2 NE 1/4 NW 1/4	" " "	" " "
		6	NE 1/4	" " "	" " "
		6	N 1/2 NE 1/4 SE 1/4	" " "	" " "

15. If the ground water supply is supplemental to an existing water supply, identification of any application for a permit, permit, certificate or adjudicated right to appropriate water made or held by the registrant.

none

Township 385 Range 1W W.M.
North

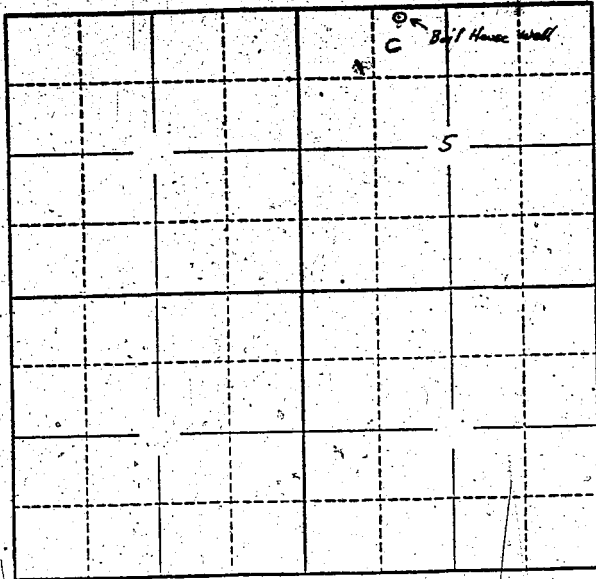

Locate well and acreage of irrigated land on plat.
Scale: 2" = 1 Mile

STATE OF OREGON
County of Jackson

} ss.

I, G. A. Cottingham, being first duly sworn, do hereby certify that I have read the foregoing Registration Statement and that all of the items therein contained are true to the best of my knowledge and belief.

By: G. A. Cottingham Secy-Treas.
(Signature of Registrant)

Subscribed and sworn to before me this 6th day of June, 19 58

My commission expires NOTARY PUBLIC FOR OREGON
(SEAL) My Commission Expires Feb. 8, 1961

G. W. Hamilton
(Notary Public)

CERTIFICATE OF REGISTRATION

STATE OF OREGON
County of Marion

} ss.

This is to certify that the foregoing Registration Statement was received in the office of the State Engineer on the 12th day of June, 1958, at 5:00 o'clock A. M. and has been duly recorded in said office in Book No. 8 of Registration Statements on page GR-1662

Witness my hand this 7th day of January, 19 59

Lewis A. Otterley
(State Engineer)

By _____ (Deputy)

\$ 20.00

GR-1662