

Registration Statement

OF CLAIMANT OF RIGHT TO APPROPRIATE GROUND WATER

TO THE STATE ENGINEER OF OREGON:

I, Harry and David, an Oregon Corporation

of P. O. Box 712, Medford County of Jackson

State of Oregon, do hereby make application for a certificate of registration as evidence of a right to appropriate ground water.

R Source from which water is withdrawn is Pump Well
(Flowing well, pump well, infiltration trench, or tunnel)

2. Location is: 2 miles South of Medford, Oregon
(Approximate distance and direction from nearest city or town)

and is more particularly described as follows:

(a) 1655 feet north and 1685 feet east from NE corner DLC #47
(Give distance and bearing to corner of section or other legal subdivision)

being within SE¹ NW¹ of Sec. 5, Twp. 38 S., Rge. 1 W.
(Smallest legal subdivision) (N. or S.) (E. or W.)

or (b) within limits of recorded platted property, town or city: _____

in Lot _____, Block _____ of _____
(Name of plat or addition)

County of _____
(If within city or town, give name)

3. Construction Work was begun on Spring 1946; was completed on Spring 1946
(Date) (Date)

and the ground water claimed was first used for the purposes set out below on Spring 1946
(Date)

since which time the water has been used intermittently
(Continuously or Intermittently)

from Spring 1946 to present
(Date) (Date)

4. Quantity of water claimed and used is 65 gallons per minute; -- acre feet per year.

5. Purpose or Purposes for which water is used manufacturing and domestic (including cold storage water, water for domestic and manufacturing in all plant and office buildings, orchard spraying, etc.)
(Domestic, irrigation, municipal, manufacturing, industrial, etc.)

6. Description of Well: Depth 125 feet. Type drilled
(Dug or drilled)

diameter 8 inches. Elevation of ground at well site 1410 feet, mean sea level.
(As near as known)

Depth to water table 12 feet.

7. Capacity of Well: 22 g.p.m. with 0 feet drawdown.

_____ g.p.m. with _____ feet drawdown.

Date of test February 13, 1958

If Flowing Well: Measured discharge _____ g.p.m. on _____
(Date)

Shut-in pressure at ground surface _____ lbs. per sq. in. on _____
(Date)

Water is controlled by _____
(Cap, valve, etc.)

If log of well is not available, give name and address of driller. don't know

11. Infiltration Trench: Covered or open _____

Dimensions: Length _____ ft. Minimum depth _____ ft. Maximum depth _____ ft.

Bottom width _____ ft. Discharge _____ g.p.m. Date of test _____

12. Tunnel: Type of lining _____

Dimensions: _____
(Length, depth, and cross sectional size)

Position of water bearing stratum with reference to portal of tunnel _____

Log of tunnel: (Preceding table for log of well may be used, if desired. Give footage from portal and character of materials, as pertinent.)

13. Pumping Equipment:

(a) Pump Shasta Submersible (2" Discharge) / Model 60T84-7L Capacity 65 g.p.m.
(Make, type and size)

(b) Motor G.E. Electric 5 H.P. (3460 RPM)
(Type and horsepower)


14. Location of area irrigated or to be irrigated, or place of use if for purposes other than irrigation.

Township North or South	Range E. or W. of Willamette Meridian	Section	Forty-acre Tract	Number Acres To Be Irrigated	Date of Reclamation
37 S.	1 W.	32	S $\frac{1}{2}$ SW $\frac{1}{4}$ SW $\frac{1}{4}$	manufacturing domestic & etc.	Spring 1946
38 S.	1 W.	5	NE $\frac{1}{4}$ NW $\frac{1}{4}$	" " "	" "
		5	NW $\frac{1}{4}$ NW $\frac{1}{4}$	" " "	" "
37 S.	1 W.	31	SE $\frac{1}{4}$ SE $\frac{1}{4}$ SW $\frac{1}{4}$	Orchard Spraying	" "
		31	S $\frac{1}{2}$ SW $\frac{1}{4}$ SE $\frac{1}{4}$	" "	" "
		31	S $\frac{1}{2}$ SE $\frac{1}{4}$ SE $\frac{1}{4}$	" "	" "
		32	S $\frac{1}{2}$ SW $\frac{1}{4}$ SW $\frac{1}{4}$	" "	" "
38 S.	1 W.	5	NW $\frac{1}{4}$	" "	" "
		5	W $\frac{1}{2}$ W $\frac{1}{2}$ SW $\frac{1}{4}$ NE $\frac{1}{4}$	" "	" "
		5	NW $\frac{1}{4}$ SW $\frac{1}{4}$	" "	" "
		6	E $\frac{1}{2}$ E $\frac{1}{2}$ NE $\frac{1}{4}$ NW $\frac{1}{4}$	" "	" "
		6	NE $\frac{1}{4}$	" "	" "
		6	N $\frac{1}{2}$ NE $\frac{1}{4}$ SE $\frac{1}{4}$	" "	" "

15. If the ground water supply is supplemental to an existing water supply, identification of any application for a permit, permit, certificate or adjudicated right to appropriate water made or held by the registrant.

NONE

Township 385 Range 1W, W.M.
North

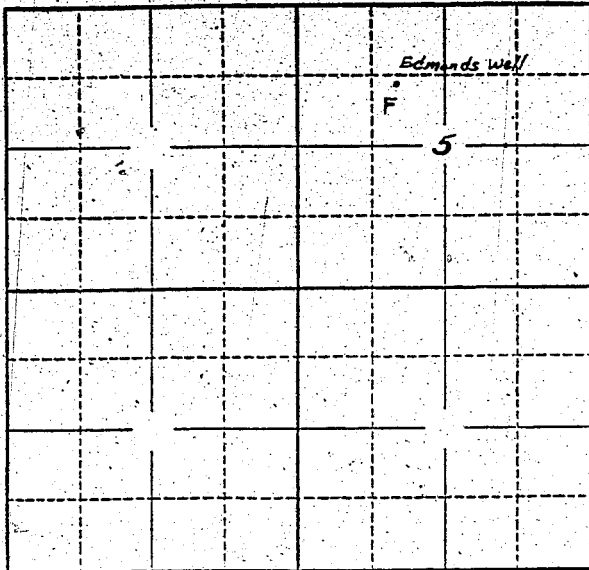

Locate well and acreage of irrigated land on plat.

Scale: 2" = 1 Mile

STATE OF OREGON

County of Jackson ss.

I, G. A. Cottingham, being first duly sworn, do hereby certify that I have read the foregoing Registration Statement and that all of the items therein contained are true to the best of my knowledge and belief.

HARRY and DAVID

By: [Signature] Secy-Treas.
(Signature of Registrant)

Subscribed and sworn to before me this 6th day of June, 19 58

My commission expires _____

[Signature]
(Notary Public)

(SEAL)

NOTARY PUBLIC FOR OREGON
My Commission Expires Feb. 8, 1964

CERTIFICATE OF REGISTRATION

STATE OF OREGON

County of Marion } ss.

This is to certify that the foregoing Registration Statement was received in the office of the State Engineer on the 12th day of June, 19 58 at 8:00 o'clock PM and has been duly recorded in said office in Book No. 8 of Registration Statements on page GR-1663

Witness my hand this 7th day of January, 19 59

[Signature]
(State Engineer)

By _____ (Deputy)

\$ 20.00

GR - 1663