

Registration Statement

OF CLAIMANT OF RIGHT TO APPROPRIATE GROUND WATER

TO THE STATE ENGINEER OF OREGON:

I, Harry and David, an Oregon Corporation

of P. O. Box 7124 Medford County of Jackson

State of Oregon ^(Mailing address) ~~do~~ hereby make application for a certificate of registration as evidence of a right to appropriate ground water.

1. Source from which water is withdrawn is Pump Well
(Flowing well, pump well, infiltration trench, or tunnel)

2. Location is: 2 Miles South of Medford, Oregon
(Approximate distance and direction from nearest city or town)

and is more particularly described as follows:

(a) 376 feet South and 55 feet West from the NE corner DLC #11
(Give distance and bearing to corner of section or other legal subdivision)
being within SE $\frac{1}{4}$ SW $\frac{1}{4}$ of Sec. 32, Twp. 37 S., Rge. 1 W.
(Smallest legal subdivision) (N. or S.) (E. or W.)

or (b) within limits of recorded platted property, town or city: _____

in Lot _____, Block _____ of _____
(Name of plat or addition)

County of _____
(If within city or town, give name)

3. Construction Work was begun on prior to 1900; was completed on 1939
(Date) (Date)

and the ground water claimed was first used for the purposes set out below on prior to 1900
(Date)

since which time the water has been used intermittently
(Continuously or Intermittently)

from prior to 1900 to present
(Date) (Date)

4. Quantity of water claimed and used is 250 gallons per minute; _____ acre feet per year.

5. Purpose or Purposes for which water is used manufacturing and domestic (including cold storage water, water for domestic and manufacturing in all plant & office bldgs orchard spraying, etc.)
(Domestic, irrigation, municipal, manufacturing, industrial, etc.)

6. Description of Well: Depth 14 feet. Type Dug
(Dug or drilled)
diameter 72 inches. Elevation of ground at well site 1410 feet, mean sea level.
(As near as known)
Depth to water table 12 feet.

7. Capacity of Well: 250 g.p.m. with 14 feet drawdown.
160 g.p.m. with 7 feet drawdown.


Date of test 15 September 57

If Flowing Well: Measured discharge _____ g.p.m. on _____
(Date)

Shut-in pressure at ground surface _____ lbs. per sq. in. on _____
(Date)

Water is controlled by _____
(Cap. valve, etc.)

Township 37 Range 1W, W.M.
North

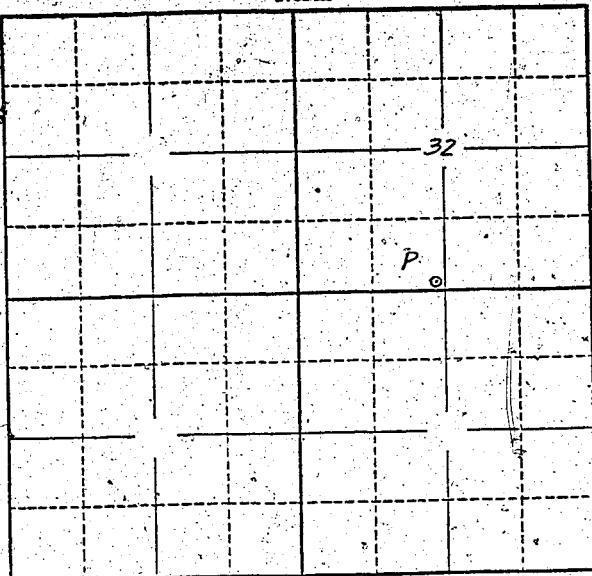

Locate well and acreage of irrigated land on plat.
Scale: 2" = 1 Mile

STATE OF OREGON }
County of Jackson } ss.

I, E. A. Cottingham, being first duly sworn, do hereby certify that I have read the foregoing Registration Statement and that all of the items therein contained are true to the best of my knowledge and belief.

By: E. A. Cottingham Secy-Treas.
(Signature of Registrant)

Subscribed and sworn to before me this 6th day of June, 1958

My commission expires _____
NOTARY PUBLIC FOR OREGON
(SEAL) My Commission Expires Feb. 8, 1961

G. W. Harrison
(Notary Public)

CERTIFICATE OF REGISTRATION

STATE OF OREGON }
County of Marion } ss.

This is to certify that the foregoing Registration Statement was received in the office of the State Engineer on the 12th day of June, 1958, at 8:00 o'clock A.M. and has been duly recorded in said office in Book No. 8 of Registration Statements on page GR-1664

Witness my hand this 7th day of January, 1959

R. A. Stanley
(State Engineer)

By _____ (Deputy)

GR-1664

\$20.00