

Registration Statement

OF CLAIMANT OF RIGHT TO APPROPRIATE GROUND WATER

(Under Chapter 708, Oregon Laws 1955.)

TO THE STATE ENGINEER OF OREGON:

I, LESTER LEE IGO

of MEDFORD County of JACKSON

State of OREGON, do hereby make application for a certificate of registration as evidence of a right to appropriate ground water.

1. Source from which water is withdrawn is PUMP WELL
(Flowing well, pump well, infiltration trench, or tunnel)

2. Location is: 3 MILES WEST + 1 MILE SOUTH OF PHOENIX ORE.
(Approximate distance and direction from nearest city or town)

and is more particularly described as follows: BEGINNING AT THE N.E. CORNER OF SEC 19

(a) 120 FT W. THENCE SOUTH 106 FT TO WELL
(Give distance and bearing to corner of section or other legal subdivision)

being within NE 1/4 OF NE 1/4 of Sec. 19, Twp. 38 S, Rge. 1 W
(Smallest legal subdivision) (N. or S.) (E. or W.)

or (b) within limits of recorded platted property, town or city: _____

in Lot _____, Block _____ of _____
(Name of plat or addition)

County of JACKSON
(If within city or town, give name)

3. Construction Work was begun on JUNE 1 1951; was completed on JUNE 15 1951
(Date) (Date)

and the ground water claimed was first used for the purposes set out below on JULY 10 1951
(Date)

since which time the water has been used INTERMITTENTLY
(Continuously or Intermittently)

from MAY 15 to OCT 1
(Date) (Date)

4. Quantity of water claimed and used is 250 gallons per minute; 5 acre feet per year.

5. Purpose or Purposes for which water is used IRRIGATION

(Domestic, irrigation, municipal, manufacturing, industrial, etc.)

6. Description of Well: Depth 15 feet, Type: DUG WELL OR SUMP
(Dug or drilled)

diameter 30 FT. inches. Elevation of ground at well site 1800 feet, mean sea level.
(As near as known)

Depth to water table APPROX 3 feet.

7. Capacity of Well: ~~252~~ 250 g.p.m. with 4 TO 5 feet drawdown.

250 g.p.m. with 4 TO 5 feet drawdown.


Date of test JUNE 1 1951

If Flowing Well: Measured discharge _____ g.p.m. on _____
(Date)

Shut-in pressure at ground surface _____ lbs. per sq. in. on _____
(Date)

Water is controlled by _____
(Cap, valve, etc.)

Township 38 S Range 1 W W.M.
North

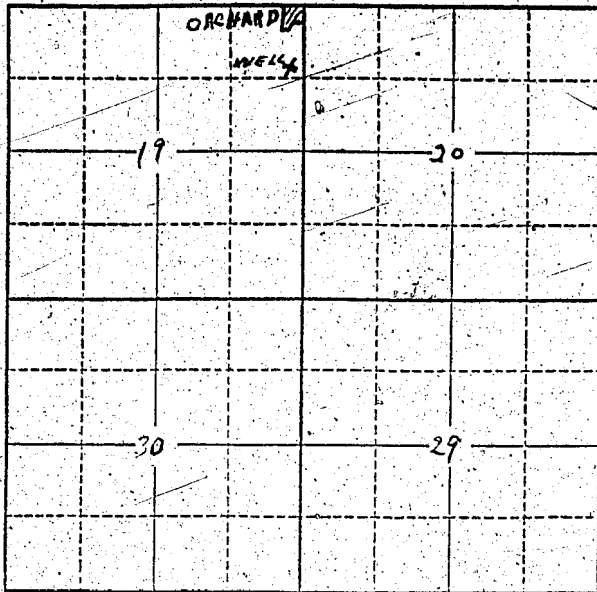

Locate well and acreage of irrigated land on plat.
Scale: 2" = 1 Mile

STATE OF OREGON }
County of JACKSON } ss.

I, LESTER LEE IGO, being first duly sworn, do hereby certify that I have read the foregoing Registration Statement and that all of the items therein contained are true to the best of my knowledge and belief.

Lester Lee Igo
(Signature of Registrant)

Subscribed and sworn to before me this 4th day of May, 1956.

My commission expires 12-16-58

Thomas A. Banks
(Notary Public)

(SEAL)

CERTIFICATE OF REGISTRATION

STATE OF OREGON }
County of Marion } ss.

This is to certify that the foregoing Registration Statement was received in the office of the State Engineer on the 7th day of May, 1956, at 8 o'clock A. M. and has been duly recorded in said office in Book No. 1 of Registration Statements on page GR-163 C

~~.....~~
~~.....~~

Witness my hand this 8th day of October, 1956.

Lewis A. Stanley
(State Engineer)

By _____
(Deputy)