

Registration No. GR 1723

Certificate No. GR 1672

Registration Statement

OF CLAIMANT OF RIGHT TO APPROPRIATE GROUND WATER

TO THE STATE ENGINEER OF OREGON:

of EUGENE County of LANE
(Mailing address)

State of OREGON, do hereby make application for a certificate of registration as evidence of a right to appropriate ground water.

1. Source from which water is withdrawn is PUMP WELL
(Flowing well, pump well, infiltration trench, or tunnel)
2. Location is: FIVE MILES
(Approximate distance and direction from nearest city or town)

and is more particularly described as follows:

(a) 1460'E & 640'S from NW CORNER SEC 12
(Give distance and bearing to corner of section or other legal subdivision)

being within NE/NW of Sec. 12, Twp. 17S, Rge. 4W
(Smallest legal subdivision) (N. or S.) (E. or W.)

or (b) within limits of recorded platted property, town or city:

in Lot _____, Block _____ of _____
(Name of plat or addition)

County of _____
(If within city or town, give name)

3. Construction Work was begun on DATE KNOWN¹⁹³⁸; was completed on 1938
(Date) (Date)

and the ground water claimed was first used for the purposes set out below on 1938 (EST)
(Date)

since which time the water has been used INTERMITTENTLY
(Continuously or intermittently)

from APRIL to NOV
(Date) (Date)

4. Quantity of water claimed and used is 82 gallons per minute; 12 1/2 acre feet per year.

5. Purpose or Purposes for which water is used IRRIGATION

(Domestic, irrigation, municipal, manufacturing, industrial, etc.)

6. Description of Well: Depth DATE KNOWN²⁰ feet. Type DOVE
(Dug or drilled)

diameter 4 inches. Elevation of ground at well site DATE KNOWN³⁷⁰ feet, mean sea level.
(As near as known)

Depth to water table DATE KNOWN feet.

7. Capacity of Well: _____ g.p.m. with _____ feet drawdown.
_____ g.p.m. with _____ feet drawdown.


Date of test _____

If Flowing Well: Measured discharge _____ g.p.m. on _____
(Date)

Shut-in pressure at ground surface _____ lbs. per sq. in. on _____
(Date)

Water is controlled by _____
(Cap, valve, etc.)

Township 17S Range 4W W.M.
North

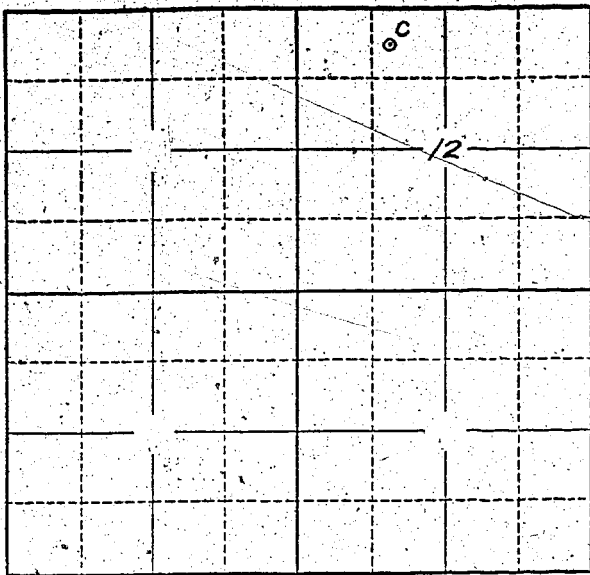

Locate well and acreage of irrigated land on plat.
Scale: 2" = 1 Mile

STATE OF OREGON }
County of Lane } ss.

I, JACK E. LANNON, being first duly sworn, do hereby certify that I have read the foregoing Registration Statement and that all of the items therein contained are true to the best of my knowledge and belief.

Jack E. Lannon
(Signature of Registrant)

Subscribed and sworn to before me this 14th day of March, 1958

My commission expires June 25, 1961
Luella A. Hansen
(Notary Public)

(SEAL)

CERTIFICATE OF REGISTRATION

STATE OF OREGON }
County of Marion } ss.

This is to certify that the foregoing Registration Statement was received in the office of the State Engineer on the 13th day of June, 1958, at 18.00 o'clock A. M. and has been duly recorded in said office in Book No. 8 of Registration Statements on page GR-1672

Witness my hand this 7th day of January, 1959

Leura A. Stanley
(State Engineer)

\$15.00

By _____
(Deputy)

GR-1672