

# Registration Statement

## OF CLAIMANT OF RIGHT TO APPROPRIATE GROUND WATER

TO THE STATE ENGINEER OF OREGON:

I, Walter F. Buseh  
of Rte 1 - Box 234 - Brooks Ore County of Marion  
(Mailing address)

State of \_\_\_\_\_ do hereby make application for a certificate of registration as evidence of a right to appropriate ground water.

1. Source from which water is withdrawn is Pump Well  
(Flowing well, pump well, infiltration trench, or tunnel)

2. Location is: 10-Miles N. of Salem  
(Approximate distance and direction from nearest city or town)

and is more particularly described as follows:

(a) 800 feet south & 50 feet west from N<sup>1</sup>/<sub>4</sub> Section 21  
(Give distance and bearing to corner of section or other legal subdivision)

being within NE<sup>1</sup>/<sub>4</sub> of NW<sup>1</sup>/<sub>4</sub> of Sec. 21, Twp. 6S Rge. 2W  
(Smallest legal subdivision) (S or N) (E or W)

or (b) within limits of recorded platted property, town or city:

in Lot \_\_\_\_\_, Block \_\_\_\_\_ of \_\_\_\_\_  
(Name of plat or addition)

County of \_\_\_\_\_  
(If within city or town, give name)

3. Construction Work was begun on June - 1946; was completed on June - 1946  
(Date) (Date)

and the ground water claimed was first used for the purposes set out below on June - 1946  
(Date)

since which time the water has been used Intermittently during season  
(Continuously or intermittently)

from June 1946 to Oct 57  
(Date) (Date)

4. Quantity of water claimed and used is 160 gallons per minute; \_\_\_\_\_ acre feet per year.

5. Purpose or Purposes for which water is used Irrigation  
(Domestic, irrigation, municipal, manufacturing, industrial, etc.)

6. Description of Well: Depth 68 feet. Type Drilled  
(Dug or drilled)

diameter 8 inches. Elevation of ground at well site \_\_\_\_\_ feet, mean sea level.  
(As near as known)

Depth to water table 6-8 feet. Summer Flows during winter

7. Capacity of Well: 160 g.p.m. with 4 feet drawdown.  
\_\_\_\_\_ g.p.m. with \_\_\_\_\_ feet drawdown.

Date of test \_\_\_\_\_

If Flowing Well: Measured discharge \_\_\_\_\_ g.p.m. on \_\_\_\_\_  
(Date)

Shut-in pressure at ground surface \_\_\_\_\_ lbs. per sq. in. on \_\_\_\_\_  
(Date)

Water is controlled by \_\_\_\_\_  
(Cap, valve, etc.)

8. Casing: (Give diameter, commercial specifications and depth below ground surface of each casing size.)

8 inch diameter Steel Casing from 0 to 68 feet  
\_\_\_\_ inch diameter \_\_\_\_\_ from \_\_\_\_\_ to \_\_\_\_\_ feet  
\_\_\_\_ inch diameter \_\_\_\_\_ from \_\_\_\_\_ to \_\_\_\_\_ feet  
\_\_\_\_ inch diameter \_\_\_\_\_ from \_\_\_\_\_ to \_\_\_\_\_ feet

Describe and show depth of shoe, plug, adapter, liner or other details: \_\_\_\_\_  
\_\_\_\_\_  
\_\_\_\_\_

9. Perforated Casings or Screens:

Unknown from \_\_\_\_\_ to \_\_\_\_\_  
(Number per foot and size of perforations, or describe screen)  
\_\_\_\_ from \_\_\_\_\_ to \_\_\_\_\_  
\_\_\_\_ from \_\_\_\_\_ to \_\_\_\_\_  
\_\_\_\_ from \_\_\_\_\_ to \_\_\_\_\_

10. Log of Well: (Describe each stratum or formation clearly, indicate if water bearing, and give thickness and depth as indicated.)

MATERIAL	Thickness (Feet)	Depth to Bottom (Feet)
<u>Unknown</u>		

If log of well is not available, give name and address of driller. Wym 0052

11. Infiltration Trench: Covered or open \_\_\_\_\_  
 Dimensions: Length \_\_\_\_\_ ft. Minimum depth \_\_\_\_\_ ft. Maximum depth \_\_\_\_\_ ft.  
 Bottom width \_\_\_\_\_ ft. Discharge \_\_\_\_\_ g.p.m. Date of test \_\_\_\_\_

12. Tunnel: Type of lining \_\_\_\_\_  
 Dimensions: \_\_\_\_\_  
(Length, course, and cross sectional size)  
 Position of water bearing stratum with reference to portal of tunnel \_\_\_\_\_

Log of tunnel: (Preceding table for log of well may be used, if desired. Give footage from portal and character of materials, as pertinent.)


13. Pumping Equipment:  
 (a) Pump Centrifugal Capacity \_\_\_\_\_ g.p.m.  
(Make, type and size)  
 (b) Motor 9 H-P 825  
(Type and horsepower)

14. Location of area irrigated or to be irrigated, or place of use if for purposes other than irrigation.

Township North or South	Range E. or W. of Willamette Meridian	Section	Forty-acre Tract	Number Acres To Be Irrigated	Date of Reclamation
T. 6 S	R 2 W	21	NW 1/4 of NE 1/4	10.0	1946
"	"	21	NE 1/4 of NW 1/4	3.0	"
"	"	21	SW 1/4 of NE 1/4	0.5	"
				<u>13.5</u>	"

15. If the ground water supply is supplemental to an existing water supply, identification of any application for a permit, permit, certificate or adjudicated right to appropriate water made or held by the registrant.

Township 6S Range 2W, W.M.  
North

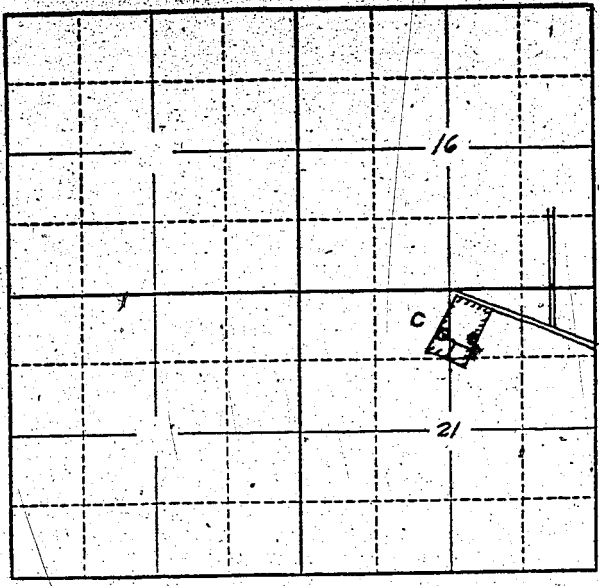

Locate well and acreage of irrigated land on plat.  
Scale: 2" = 1 Mile

STATE OF OREGON }  
County of Marion } ss.

I, Walter F. Busch, being first duly sworn, do hereby certify that I have read the foregoing Registration Statement and that all of the items therein contained are true to the best of my knowledge and belief.

Walter F. Busch  
(Signature of Registrant)

Subscribed and sworn to before me this 13th day of June, 1958

My commission expires 12th June 1961 Wm. S. Bartholomew  
(Notary Public)

(SEAL)

**CERTIFICATE OF REGISTRATION**

STATE OF OREGON }  
County of Marion } ss.

This is to certify that the foregoing Registration Statement was received in the office of the State Engineer on the 13th day of June, 1958, at 2<sup>00</sup> o'clock P. M. and has been duly recorded in said office in Book No. B of Registration Statements on page GR-1674

Witness my hand this 7th day of January, 1959

Leura A. Stanley  
(State Engineer)

By \_\_\_\_\_ (Deputy)

\$15.00

GR-1674