

Registration Statement

OF CLAIMANT OF RIGHT TO APPROPRIATE GROUND WATER

TO THE STATE ENGINEER OF OREGON:

I, Earl & Hazel Wheatlers
of 112 Bay St Salem County of Marian
(Mailing address)

State of Oregon, do hereby make application for a certificate of registration as evidence of a right to appropriate ground water.

1. Source from which water is withdrawn is PUMP WELL #1
(Flowing well, pump well, infiltration trench, or tunnel)

2. Location is: 6 Miles North + West of Salem
(Approximate distance and direction from nearest city or town)

and is more particularly described as follows:

(a) 1200' W x 550' S FROM NE CORNER SECTION 33
(Give distance and bearing to corner of section or other legal subdivision)

being within NE 1/4 - NE 1/4 of Sec. 33, Twp. 6 S, Rge. 311
(Smallest legal subdivision) (T. or S.) (E. or W.)

or (b) within limits of recorded platted property, town or city:

in Lot _____, Block _____ of _____
(Name of plat or addition)

County of _____
(If within city or town, give name)

3. Construction Work was begun on 1953; was completed on 1953
(Date) (Date)

and the ground water claimed was first used for the purposes set out below on 1953
(Date)

since which time the water has been used Continuously
(Continuously or intermittently)

from 1953 to May 1958
(Date) (Date)

4. Quantity of water claimed and used is 500 gallons per minute; 12 acre feet per year.

5. Purpose or Purposes for which water is used Irrigation
(Domestic, irrigation, municipal, manufacturing, industrial, etc.)

6. Description of Well: Depth 29 feet. Type Drilled
(Dug or drilled)

diameter 2 inches. Elevation of ground at well site 130 feet, mean sea level.
(As near as known)

Depth to water table 17 feet.

7. Capacity of Well: 500 g.p.m. with 3 feet drawdown.

_____ g.p.m. with _____ feet drawdown.

Date of test May 10 1958

If Flowing Well: Measured discharge _____ g.p.m. on _____
(Date)

Shut-in pressure at ground surface _____ lbs. per sq. in. on _____
(Date)

Water is controlled by _____
(Cap, valve, etc.)

8. Casing: (Give diameter, commercial specifications and depth below ground surface of each casing size.)

8 inch diameter from Top to 29 feet
 inch diameter from to feet
 inch diameter from to feet
 inch diameter from to feet

Describe and show depth of shoe, plug, adapter, liner or other details: Steel shoe on bottom

9. Perforated Casings or Screens:

1/2 x 6" slots 8 per foot from 27/11 to 29/11
(Number per foot and size of perforations, or describe screen)
 from to
 from to
 from to

10. Log of Well: (Describe each stratum or formation clearly, indicate if water bearing, and give thickness and depth as indicated.)

MATERIAL	Thickness (Feet)	Depth to Bottom (Feet)
Sandy loam	11	11
Gravel	15	26

If log of well is not available, give name and address of driller. Marian Elkert
4120 Market St Salem Ore

11. Infiltration Trench: Covered or open _____
 Dimensions: Length _____ ft. Minimum depth _____ ft. Maximum depth _____ ft.
 Bottom width _____ ft. Discharge _____ g.p.m. Date of test _____

12. Tunnel: Type of lining _____
 Dimensions: _____
(Length, course, and cross sectional size)
 Position of water bearing stratum with reference to portal of tunnel _____

Log of tunnel: (Preceding table for log of well may be used, if desired. Give footage from portal and character of materials, as pertinent.)


13. Pumping Equipment:
 (a) Pump Cornell Centrifugal Pump Capacity 500 g.p.m.
(Make, type and size)
 (b) Motor Electric 20 H.P.
(Type and horsepower)

14. Location of area irrigated or to be irrigated, or place of use if for purposes other than irrigation.

Township North or South	Range E. or W. of Williams Meridian	Section	Forty-acre Tract	Number Acres To Be Irrigated	Date of Reclamation
6-S	3-W	33	N.E. 1/4 - N.E. 2/4	8 1/2	1953

15. If the ground water supply is supplemental to an existing water supply, identification of any application for a permit, permit, certificate or adjudicated right to appropriate water made or held by the registrant.

Township 65 Range 31, W.M.
North

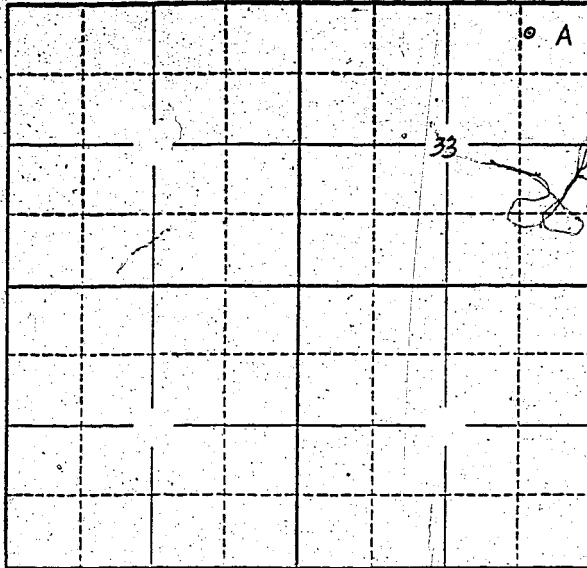

Locate well and acreage of irrigated land on plat.
Scale: 2" = 1 Mile

STATE OF OREGON }
County of Marion } ss.

I, _____ being first duly sworn, do hereby certify that I have read the foregoing Registration Statement and that all of the items therein contained are true to the best of my knowledge and belief.

Earl Weathers
(Signature of Registrant)

Subscribed and sworn to before me this 13th day of June, 1958

My commission expires 12th June 1961 Wm. D. Bartholmeus
(Notary Public)

(SEAL)

CERTIFICATE OF REGISTRATION

STATE OF OREGON }
County of Marion } ss.

This is to certify that the foregoing Registration Statement was received in the office of the State Engineer on the 13th day of June, 1958, at 10:30 o'clock A. M. and has been duly recorded in said office in Book No. 8 of Registration Statements on page GR-1675

Witness my hand this 7th day of January, 1959

\$1,500

Lewis A. Stanley
(State Engineer)

By _____ (Deputy)

GR-1675