

Registration Statement

OF CLAIMANT OF RIGHT TO APPROPRIATE GROUND WATER

TO THE STATE ENGINEER OF OREGON:

I, EARL & HAZEL WEATHERS

of RTE. 2 BOX 77 SALEM County of MARION
(Mailing address)

State of OREGON, do hereby make application for a certificate of registration as evidence of a right to appropriate ground water.

1. Source from which water is withdrawn is PUMP WELL #2
(Flowing well, pump well, infiltration trench, or tunnel)

2. Location is: 6 Miles North & West of Salem
(Approximate distance and direction from nearest city or town)

and is more particularly described as follows:

(a) 400 Ft. W. & 1600 Ft. S. from N.E. Corner Section 33
(Give distance and bearing to corner of section or other legal subdivision)
being within S.E. 1/4 - N.E. 1/4 Section 33 of Sec. 33, Twp. 6 S., Rge. 3 W.
(Smallest legal subdivision) (N. or S.) (E. or W.)

or (b) within limits of recorded platted property, town or city:

in Lot _____, Block _____ of _____
(Name of plat or addition)

County of _____
(If within city or town, give name)

3. Construction Work was begun on June 9, 1953; was completed on June 11, 1953.
(Date) (Date)

and the ground water claimed was first used for the purposes set out below on June 15, 1953
(Date)

since which time the water has been used Intermittently
(Continuously or Intermittently)

from June 15, 1953 to May 25, 1958
(Date) (Date)

4. Quantity of water claimed and used is 500 gallons per minute; 1 1/2 acre feet per year.

5. Purpose or Purposes for which water is used Irrigation

(Domestic, irrigation, municipal, manufacturing, industrial, etc.)

6. Description of Well: Depth 41 feet Type Drilled
(Dug or drilled)

diameter 8 inches. Elevation of ground at well site 130 feet, mean sea level.
(As near as known)

Depth to water table 18 feet.

7. Capacity of Well: 600 g.p.m. with 8 feet drawdown.

_____ g.p.m. with _____ feet drawdown.


Date of test June 11, 1953

If Flowing Well: Measured discharge _____ g.p.m. on _____
(Date)

Shut-in pressure at ground surface _____ lbs. per sq. in. on _____
(Date)

Water is controlled by _____
(Cap, valve, etc.)

Township 65 Range 3W W.M.
North

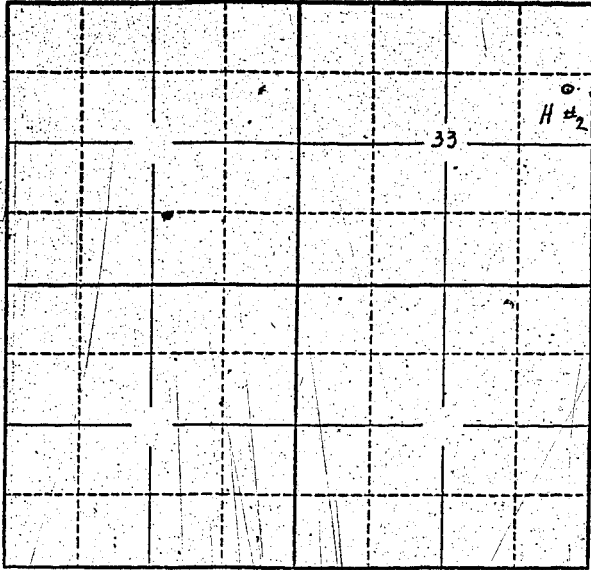

Locate well and acreage of irrigated land on plat.
Scale: 2" = 1 Mile

STATE OF OREGON

County of Marion } ss.

I, _____ being first duly sworn, do hereby certify that I have read the foregoing Registration Statement and that all of the items therein contained are true to the best of my knowledge and belief.

Earl M. Weatheris
(Signature of Registrant)

Subscribed and sworn to before me this 13th day of June 1958

My commission expires 12th June 1961 Wm. D. Bartholomew
(Notary Public)

(SEAL)

CERTIFICATE OF REGISTRATION

STATE OF OREGON

County of Marion } ss.

This is to certify that the foregoing Registration Statement was received in the office of the State Engineer on the 13th day of June 1958, at 10:30 o'clock A. M. and has been duly recorded in said office in Book No. 8 of Registration Statements on page GR-1676.

Witness my hand this 7th day of January 1959

Lewis A. Stanley
(State Engineer)

\$ 1500.00

By _____ (Deputy)

GR-1676