

RECEIVED
JUN 17 1958

STATE ENGINEER
SALEM, OREGON

Registration No. GR 1736

Certificate No. GR 1684

Registration Statement

OF CLAIMANT OF RIGHT TO APPROPRIATE GROUND WATER

TO THE STATE ENGINEER OF OREGON:

I, A. C. and May Raines
of Route 2, Box 192 A, Lebanon County of Linn
(Mailing address)

State of Oregon, do hereby make application for a certificate of registration as evidence of a right to appropriate ground water.

1. Source from which water is withdrawn is pump well
(Flowing well, pump well, infiltration trench, or tunnel)

2. Location is: 4 miles NE of Lebanon, Oregon
(Approximate distance and direction from nearest city or town)

and is more particularly described as follows:

(a) 501' south and 2145' East of NW corner DLC 69, T. 11 S, R. 2 W.
(Give distance and bearing to corner of section or other legal subdivision)

being within SE 1/4 of NE 1/4 SE 1/4 of NW 1/4 of Sec. 35, Twp. 11 S, Rge. 2 W
(Smallest legal subdivision) (N. or S.) (E. or W.)

or (b) within limits of recorded platted property, town or city:

in Lot _____, Block _____ of _____
(Name of plat or addition)

County of Linn
(If within city or town, give name)

3. Construction Work was begun on October 1947; was completed on October 1947
(Date) (Date)

and the ground water claimed was first used for the purposes set out below on June 1948
(Date)

since which time the water has been used continuously
(Continuously or intermittently)

from June 1948 to present time
(Date) (Date)

4. Quantity of water claimed and used is 126 gallons per minute; 21.0 acre feet per year.

5. Purpose or Purposes for which water is used Irrigation

(Domestic, irrigation, municipal, manufacturing, industrial, etc.)

6. Description of Well: Depth 65 feet. Type Drilled
(Dug or drilled)

diameter 6 inches. Elevation of ground at well site 310 feet, mean sea level.
(As near as known)

Depth to water table 11 feet.

7. Capacity of Well: 200 g.p.m. with 1 1/2 feet drawdown.

_____ g.p.m. with _____ feet drawdown.


Date of test June 1948

If Flowing Well: Measured discharge _____ g.p.m. on _____
(Date)

Shut-in pressure at ground surface _____ lbs. per sq. in. on _____
(Date)

Water is controlled by _____
(Cap, valve, etc.)

Township 11 S Range 2 W, W.M.
North

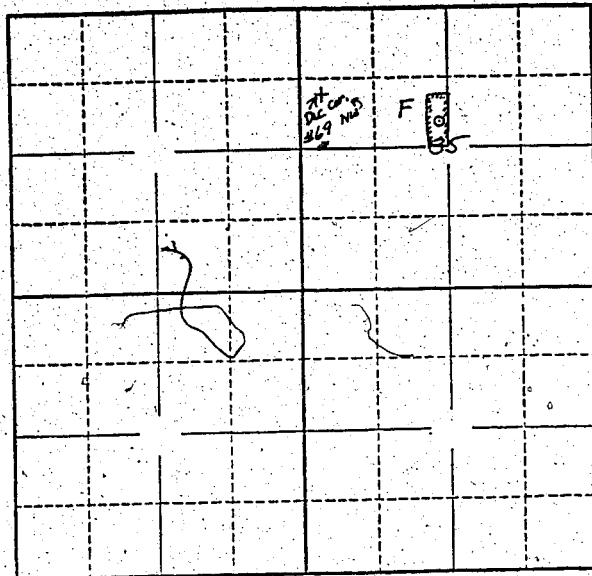

Locate well and acreage of irrigated land on plat.
Scale: 2" = 1 Mile

STATE OF OREGON

County of Linn } ss.

I, A. C. and May Raines, being first duly sworn, do hereby certify that I have read the foregoing Registration Statement and that all of the items therein contained are true to the best of my knowledge and belief.

A.C. Raines
May Raines
(Signature of Registrant)

Subscribed and sworn to before me this 13th day of June, 19 58.

My commission expires July 13, 1958

Alta Gibson
(Notary Public)

(SEAL)

CERTIFICATE OF REGISTRATION

STATE OF OREGON

County of Marion } ss.

This is to certify that the foregoing Registration Statement was received in the office of the State Engineer on the 17th day of June, 19 58, at 8:00 o'clock A.M. and has been duly recorded in said office in Book No. 8 of Registration Statements on page GR-1684

Witness my hand this 7th day of January

Lawrence A. Stanley
(State Engineer)

By _____ (Deputy)

15.00

GR-1684