

RECEIVED  
JUN 18 1958  
STATE ENGINEER  
SALAS, OREGON

# Registration Statement

REGISTRATION NO. GR-1739  
CERTIFICATE NO. GR-4047

## OF CLAIMANT OF RIGHT TO APPROPRIATE GROUND WATER

(Under Chapter 708, Oregon Laws 1955.)

TO THE STATE ENGINEER OF OREGON:

I, Frank B. Haulton  
of Central Point Ore County of Jackson  
State of Oregon, do hereby make application for a certificate of registration as evidence of a right to appropriate ground water.

- Source from which water is withdrawn is Pump Well  
(Flowing well, pump well, infiltration trench, or tunnel)
- Location is: 1/2 mile north from Madras - 3 from Central Point  
(Approximate distance and direction from nearest city or town)

and is more particularly described as follows: 470 feet west & 100 feet north from SW corner Section 36

(a) Being at approx. 800 ft S of NW corner of SE 1/4 of sec 36 Twp 26 R 24  
(Give distance and bearing to corner of section or other legal subdivision)  
being within SE 1/4 of SW 1/4 of Sec. 36, Twp. 26 S, Rge. 24 W  
(Smallest legal subdivision) (or S.) (or W.)

or (b) within limits of recorded platted property, town or city:  
in Lot \_\_\_\_\_, Block \_\_\_\_\_ of \_\_\_\_\_  
(Name of plat or addition)  
County of Jackson  
(If within city or town, give name)

3. Construction Work was begun on May 1944; was completed on July 30 1955  
(Date) (Date)  
and the ground water claimed was first used for the purposes set out below on 1946 early summer  
(Date)  
since which time the water has been used Continuously for irrigation  
(Continuously or Intermittently)  
from May to September  
(Date) (Date)

4. Quantity of water claimed and used is 15 gallons per minute; 1/2 acre feet per year.  
5. Purpose or Purposes for which water is used pasture  
(Domestic, irrigation, municipal, manufacturing, industrial, etc.)

6. Description of Well: Depth 95 feet. Type Drug  
(Dug or drilled)  
diameter 1' x 12" inches. Elevation of ground at well site 1300 feet, mean sea level.  
(As near as known)  
Depth to water table 18 feet.

7. Capacity of Well: 15 g.p.m. with 9 feet drawdown.  
\_\_\_\_\_ g.p.m. with \_\_\_\_\_ feet drawdown.  
Date of test July 30 1955  
If Flowing Well: Measured discharge \_\_\_\_\_ g.p.m. on \_\_\_\_\_  
(Date)  
Shut-in pressure at ground surface \_\_\_\_\_ lbs. per sq. in. on \_\_\_\_\_  
(Date)  
Water is controlled by \_\_\_\_\_  
(Cap, valve, etc.)

8. Casing: (Give diameter, commercial specifications and depth below ground surface of each casing size.)

*unk* inch diameter ..... from ..... to ..... feet  
 ..... inch diameter ..... from ..... to ..... feet  
 ..... inch diameter ..... from ..... to ..... feet  
 ..... inch diameter ..... from ..... to ..... feet

Describe and show depth of shoe, plug, adapter, liner or other details: .....

9. Perforated Casings or Screens:

*unk* ..... from ..... to .....  
 (Number per foot and size of perforations, or describe screen)  
 ..... from ..... to .....  
 ..... from ..... to .....  
 ..... from ..... to .....

10. Log of Well: (Describe each stratum or formation clearly, indicate if water bearing, and give thickness and depth as indicated.)

MATERIAL	Thickness (Feet)	Depth to Bottom (Feet)
<i>unk</i>		

If log of well is not available, give name and address of driller. ....

11. Infiltration Trench: Covered or open .....

Dimensions: Length 12 ft. Minimum depth 35 ft. Maximum depth 36 ft.

Bottom width 6 ft. Discharge 15 g.p.m. Date of test .....

12. Tunnel: Type of lining .....

Dimensions: .....  
(Length, course, and cross sectional size)

Position of water bearing stratum with reference to portal of tunnel .....

Log of tunnel: (Preceding table for log of well may be used, if desired. Give footage from portal and character of materials, as pertinent.)

13. Pumping Equipment:

(a) Pump Hornum - 1 1/2' - 1 7/8" pipe Capacity 20 ~~1000~~ g.p.m.  
(Make, type and size)


(b) Motor 1 - H.P. J&K  
(Type and horsepower)

14. Location of area irrigated or to be irrigated, or place of use if for purposes other than irrigation.

Township North or South	Range E. or W. of Willamette Meridian	Section	Forty-acre Tract	Number Acres To Be Irrigated	Date of Reclamation
T36S	R2W	36	SE 1/4 of the SW 1/4	1 1/2	July 1952

15. If the ground water supply is supplemental to an existing water supply, identification of any application for a permit, permit, certificate or adjudicated right to appropriate water made or held by the registrant.

Township 36 S Range 2 W, W.M.  
North

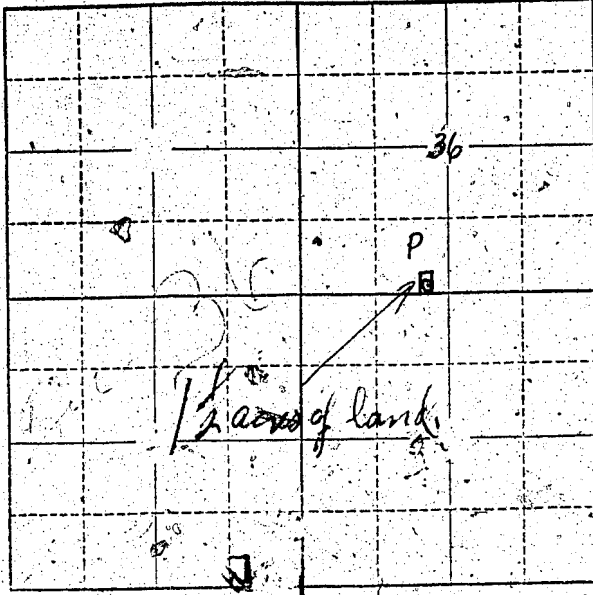

Sec 36

Locate well and acreage of irrigated land on plat.

Scale: 2" = 1 Mile  
4" = 1 "

STATE OF OREGON

County of Jackson } ss.

I, Frank B. Hazlett, being first duly sworn, do hereby certify that I have read the foregoing Registration Statement and that all of the items therein contained are true to the best of my knowledge and belief.

Frank B. Hazlett  
(Signature of Registrant)

Subscribed and sworn to before me this 4 day of April, 1960

My commission expires MY COMMISSION EXPIRES JULY 29, 1963

Margaret Hapt  
(Notary Public)

(SEAL)

**CERTIFICATE OF REGISTRATION**

STATE OF OREGON } ss.  
County of Marion

This is to certify that the foregoing Registration Statement was received in the office of the State Engineer on the 16th day of June, 1960, at 2:00 o'clock A.M. and has been duly recorded in said office in Book No. 17 of Registration Statements on page GR 4047

~~Construction shall be completed by \_\_\_\_\_ and the water completely applied to \_\_\_\_\_~~  
~~land for use by \_\_\_\_\_~~

Witness my hand this 16th day of May, 1960

Lewis A. Starnes  
(State Engineer)

#1500

By \_\_\_\_\_ (Deputy)

GR 4047