

RECEIVED  
MAR 20 1956  
STATE ENGINEER  
SALEM, OREGON

REGISTRATION NO. GR-171

CERTIFICATE NO. GR-164

### Registration Statement

#### OF CLAIMANT OF RIGHT TO APPROPRIATE GROUND WATER

(Under Chapter 708, Oregon Laws 1955.)

TO THE STATE ENGINEER OF OREGON:

I, D. D. MENSEN

of Seaside, RT 2 Box 797 County of Clatsop

State of Oregon, do hereby make application for a certificate of registration as evidence of a right to appropriate ground water.

1. Source from which water is withdrawn is Pump well  
(Flowing well, pump well, infiltration trench, or tunnel)

2. Location is: 1 1/2 miles north of Seaside  
(Approximate distance and direction from nearest city or town)

and is more particularly described as follows: Part of the S<sub>2</sub> of Sec. 33, T. 1 S., R. 3 E.W.M, described: Beg. at an iron stake in the E. and W. center line through Sec. 33, Twp. 1 S., R. 3 E.W.M, said iron stake) bearing W. 1910.50 ft. from the 1 Sec. cor. on the E. side of Sec. 33.  
(Give distance and bearing to corner of section or other legal subdivision)

being within S.W. 1/4 of SE 1/4 of Sec. 33, Twp. 1 S, Rge. 3 E  
(Smallest legal subdivision) (N. or S.) (E. or W.)

or (b) within limits of recorded platted property, town or city: \_\_\_\_\_

in Lot \_\_\_\_\_, Block \_\_\_\_\_ of \_\_\_\_\_  
(Name of plat or addition)

County of \_\_\_\_\_  
(If within city or town, give name)

3. Construction Work was begun on April 1953; was completed on April 1953  
(Date) (Date)

and the ground water claimed was first used for the purposes set out below on April 1953  
(Date)

since which time the water has been used intermittently for irrigation  
(Continuously or intermittently)

from Aug. 1953 to Sept 1953  
(Date) (Date)

4. Quantity of water claimed and used is \_\_\_\_\_ gallons per minute; \_\_\_\_\_ acre feet per year.

5. Purpose or Purposes for which water is used \_\_\_\_\_  
(Domestic, irrigation, municipal, manufacturing, industrial, etc.)

6. Description of Well: Depth \_\_\_\_\_ feet. Type \_\_\_\_\_  
(Dug or drilled)

diameter \_\_\_\_\_ inches. Elevation of ground at well site \_\_\_\_\_ feet, mean sea level.  
(As near as known)

Depth to water table \_\_\_\_\_ feet.

7. Capacity of Well: \_\_\_\_\_ g.p.m. with \_\_\_\_\_ feet drawdown.

\_\_\_\_\_ g.p.m. with \_\_\_\_\_ feet drawdown.

Date of test Aug 1953

If Flowing Well: Measured discharge \_\_\_\_\_ g.p.m. on \_\_\_\_\_  
(Date)

Shut-in pressure at ground surface \_\_\_\_\_ lbs. per sq. in. on \_\_\_\_\_  
(Date)

Water is controlled by \_\_\_\_\_  
(Cap, valve, etc.)

8. Casing: (Give diameter, commercial specifications and depth below ground surface of each casing size.)

6 inch diameter ..... from 0 to 245 feet  
 6 inch diameter ..... from 245 to 311 feet  
 inch diameter ..... from ..... to ..... feet  
 inch diameter ..... from ..... to ..... feet

Describe and show depth of shoe, plug, adapter, liner or other details: .....

9. Perforated Casings or Screens:

H  $\frac{1}{2} \times 1$  in. perforations at 3 levels from 182 ft to .....  
(Number per foot and size of perforations, or describe screen)  
 from 210 ft to .....  
 from 230 ft to .....  
 bottom 10 ft of casing is perforated from ..... to .....

10. Log of Well: (Describe each stratum or formation clearly, indicate if water bearing, and give thickness and depth as indicated.)

MATERIAL	Thickness (Feet)	Depth to Bottom (Feet)
Topsoil clay scattered boulders	40	40
cemented gravel	106	146
yellow clay	6	152
cemented gravel	24	176
clay, brown	4	180
cemented gravel with soft or loose layers with estimated water bearing capacity of up to 35 Gallons per minute at each layer as indicated at perforation levels above.	64	244
blue & green clay	54	298
loose water bearing gravel	2	300
sandstone	5	305

If log of well is not available, give name and address of driller. ....

11. Infiltration Trench: Covered or open .....

Dimensions: Length ..... ft. Minimum depth ..... ft. Maximum depth ..... ft.

Bottom width ..... ft. Discharge ..... g.p.m. Date of test .....

12. Tunnel: Type of lining .....

Dimensions: .....  
(Length, course, and cross sectional size)

Position of water bearing stratum with reference to portal of tunnel .....

Log of tunnel: (Preceding table for log of well may be used, if desired. Give footage from portal and character of materials, as pertinent.)

13. Pumping Equipment:

(a) Pump ..... *Turbine* ..... Capacity *200 Gal at well* g.p.m.  
(Make, type and size)

(b) Motor *20 hp* *electric* .....  
(Type and horsepower)


14. Location of area irrigated or to be irrigated, or place of use if for purposes other than irrigation.

Township North or South	Range E. or W. of Willamette Meridian	Section	Forty-acre Tract	Number Acres To Be Irrigated	Date of Reclamation
1S	3E	33	SE $\frac{1}{4}$ of SW $\frac{1}{4}$	3.0	Aug. 1953
			NE $\frac{1}{4}$ of SW $\frac{1}{4}$	5.0	
			NW $\frac{1}{4}$ of SE $\frac{1}{4}$	20.79	
			SW $\frac{1}{4}$ of SE $\frac{1}{4}$	23.34	
				<u>52.13</u>	

15. If the ground water supply is supplemental to an existing water supply, identification of any application for a permit, permit, certificate or adjudicated right to appropriate water made or held by the registrant.

Section 33 T. 15. N. 3E

Township 15 Range 3E W.M. North

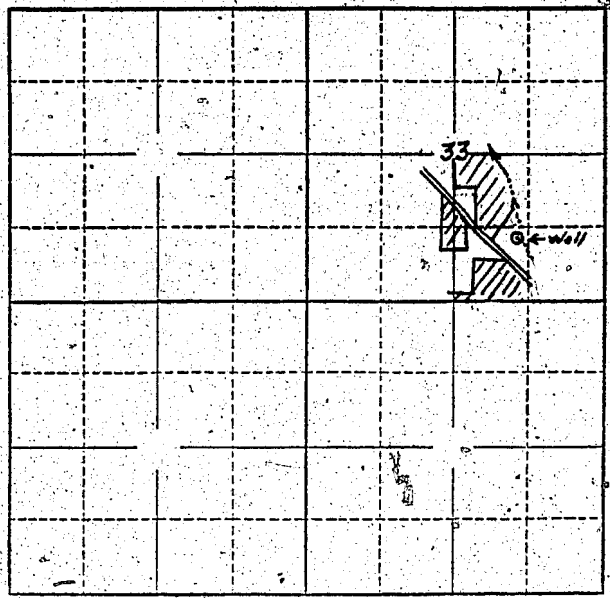

Locate well and acreage of irrigated land on plat. Scale: 2" = 1 Mile

STATE OF OREGON }  
County of Blackamus } ss.

I, Edis D. Munsie, being first duly sworn, do hereby certify that I have read the foregoing Registration Statement and that all of the items therein contained are true to the best of my knowledge and belief.

*Edis D. Munsie*  
(Signature of Registrant)

Subscribed and sworn to before me this 6<sup>th</sup> day of February, 1956.

My Commission expires March 27, 1957 *[Signature]*  
(Notary Public)

(SEAL)

CERTIFICATE OF REGISTRATION

STATE OF OREGON }  
County of Marion } ss.

This is to certify that the foregoing Registration Statement was received in the office of the State Engineer on the 20<sup>th</sup> day of March, 1956, at 8 o'clock A.M. and has been duly recorded in said office in Book No. 1 of Registration Statements on page GR-164 C.


Witness my hand this 8<sup>th</sup> day of October, 1956.

*Laura A. Stanley*  
(State Engineer)

By \_\_\_\_\_ (Deputy)

GR-164 C