

SCHOOL WELL

RECEIVED
APR 7 1958
STATE ENGINEER
SALEM, OREGON

REGISTRATION NO GR-1740
CERTIFICATE No GR-1687

Registration Statement

RECEIVED
JUN 18 1958
STATE ENGINEER
SALEM, OREGON

OF CLAIMANT OF RIGHT TO APPROPRIATE GROUND WATER

(Under Chapter 708, Oregon Laws 1955)

TO THE STATE ENGINEER OF OREGON:

1040 Lancaster Drive, NE

I, SERRA CATHOLIC HIGH SCHOOL
of SALEM County of MARION

State of OREGON, do hereby make application for a certificate of registration as evidence of a right to appropriate ground water.

1. Source from which water is withdrawn is PUMP WELL #1
(Flowing well, pump well, infiltration trench, or tunnel)

2. Location is: 2 MILES EAST OF SALEM
(Approximate distance and direction from nearest city or town)

and is more particularly described as follows: 2000 feet east & 600 feet North from SW corner Section 19.

(a) 560' ft East and 90' North of tract Described
(Give distance and bearing to corner of section or other legal subdivision)

being within SE 1/4 of SW 1/4 of Sec. 19, Twp. 7 S, Rge. 2 W W 1
(Smallest legal subdivision) (N. or S.) (E. or W.)

or (b) within limits of recorded platted property, town or city:

in Lot _____, Block _____ of _____
(Name of plat or addition)

County of _____
(If within city or town, give name)

3. Construction Work was begun on 5-11-1954; was completed on 5-14-1954
(Date) (Date)

and the ground water claimed was first used for the purposes set out below on 5-19-54
(Date)

since which time the water has been used Continuously
(Continuously or intermittently)

from 5-19-54 to April 1958
(Date) (Date)

4. Quantity of water claimed and used is 200 gallons per minute; 1.5 acre feet per year.

5. Purpose or Purposes for which water is used SCHOOL PURPOSES + IRRIGATION OF LAWN
(Domestic, irrigation, municipal, manufacturing, industrial, etc.)

6. Description of Well: Depth 116' feet. Type DRILLED
(Dug or drilled)

diameter 8" 1-0 inches. Elevation of ground at well site 207 00 feet, mean sea level.
(As near as known)

Depth to water table 18' feet.

7. Capacity of Well: _____ g.p.m. with _____ feet drawdown. BAILER TEST 75 G.P.M. 2' DRAW DOWN

_____ g.p.m. with _____ feet drawdown.
Date of test BAILER TEST 5-19-1954 NO PUMP TEST MADE TO THE KNOWLEDGE OF DRILLER # 6

If Flowing Well: Measured discharge _____ g.p.m. on _____
(Date)

Shut-in pressure at ground surface _____ lbs. per sq. in. on _____
(Date)

Water is controlled by _____
(Cap, valve, etc.)

D

8. Casing: (Give diameter, commercial specifications and depth below ground surface of each casing size.)

8" I.D. inch diameter $\frac{1}{2}$ " WALL THICKNESS from 1' to 116' feet
 inch diameter from to feet
 inch diameter from to feet
 inch diameter from to feet

Describe and show depth of shoe, plug, adapter, liner or other details: 8" SPRING STEEL SHOE WELDED TO BOTTOM OF LOWER JOINT - - CASING HAS NO PLUGS - ADAPTERS OR LINERS ATTACHED

9. Perforated Casings or Screens:

HOLES PUNCHED AT RANDOM 170 from 70' to 115'
(Number per foot and size of perforations, or describe screen)
 WATER ALSO ENTERS THROUGH BOTTOM OF CASING 196' from to
 NO SCREEN INSTALLED from to
 from to

10. Log of Well: (Describe each stratum or formation clearly, indicate if water bearing, and give thickness and depth as indicated.)

MATERIAL	Thickness (Feet)	Depth to Bottom (Feet)
SUBSOIL	20'	20'
BLUE SILT	8'	28'
BLUE CLAY	14'	42'
CEMENTED GRAVEL	10'	52'
WATER SAND + GRAVEL - SULPHUR - 60 G.P.M.	2'	54'
CEMENT GRAVEL INTERMITTENT WATER SEAMS	9'	63'
CEMENT SAND + GRAVEL IMBEDDED IN YELLOW CLAY	1'	64'
CEMENT GRAVEL INTERMITTENT WATER SEAMS	9'	73'
CEMENT SAND + GRAVEL IMBEDDED IN BROWN CLAY	4'	77'
CEMENT GRAVEL INTERMITTENT WATER SEAMS	12'	89'
WATER SAND + GRAVEL 50 G.P.M.	1'	90'
CEMENT SAND + GRAVEL HEAVY WITH BROWN CLAY	25'	115'
WATER SAND + GRAVEL	1'	116'

If log of well is not available, give name and address of driller. J.A. SNEED & SONS

WELL DRILLERS LICENSE # 6

11. Infiltration Trench: Covered or open _____
 Dimensions: Length _____ ft. Minimum depth _____ ft. Maximum depth _____ ft.
 Bottom width _____ ft. Discharge _____ g.p.m. Date of test _____

12. Tunnel: Type of lining L
 Dimensions: _____
(Length, course, and cross sectional size)
 Position of water bearing stratum with reference to portal of tunnel _____

Log of tunnel: (Preceding table for log of well may be used, if desired. Give footage from portal and character of materials, as pertinent.)


13. Pumping Equipment:
 (a) Pump Fairbank Morse KZKV Capacity 200 g.p.m.
(Make, type and size)
 (b) Motor 10HP 60 cycle 3 Ph 3450 RPM Frame Size 2KV 12-76 F
(Type and horsepower)

14. Location of area irrigated or to be irrigated, or place of use if for purposes other than irrigation.

Township North or South	Range E. or W. of Willamette Meridian	Section	Four-acre Tract	Number Acres To Be Irrigated	Date of Reclamation
<p>Beginning at a point South 4 45' East 13.06 chains from the Northeast Corner of Issac Baker's Donation Land Claim No. 91; thence North 89 45' East 31.21 chains more or less to the West line of Findley's Fruit and Garden Tracts; thence South 10 and four 1/100 chains parallel with the West line of Zachariah Pollard's Donation Land Claim; thence South 39 45' West 29.795 chains to the East line of said claim No. 91; thence North 4 45' West following the East line of aforesaid claim No. 91, 10.43 chains to the place of beginning being a part of Jacob Robbin's Donation Land Claim Notification No. 5383; Cert. No 2932, situated in T. 7, S. R. 2, West of the Willamette Mer., Marion County, State of Oregon</p>					
T7S	R2W	19	SE 1/4 of SW 1/4 about 7 Ac		1954

15. If the ground water supply is supplemental to an existing water supply, identification of any application for a permit, permit, certificate or adjudicated right to appropriate water made or held by the registrant.

Township 75 Range 2 W, W.M.
North

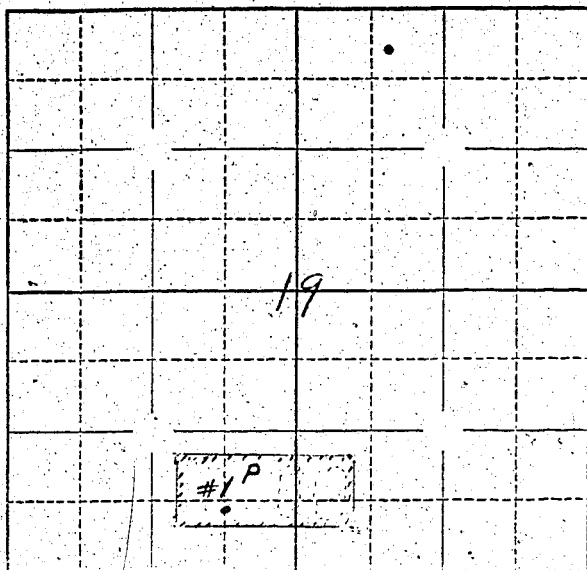

Locate well and acreage of irrigated land on plat.

Scale: \blacksquare = 1 Mile
4" = 1 Mile

STATE OF OREGON

County of Marion } ss.

I, Jose Luis de Parrales, being first duly sworn, do hereby certify that I have read the foregoing Registration Statement and that all of the items therein contained are true to the best of my knowledge and belief.

Jose Luis de Parrales
(Signature of Registrant)

Subscribed and sworn to before me this 3 day of April, 1958.

My commission expires July 27 1958 Louis W. Amort
(Notary Public)

(SEAL)

CERTIFICATE OF REGISTRATION

STATE OF OREGON

County of Marion } ss.

This is to certify that the foregoing Registration Statement was received in the office of the State Engineer on the 15th day of June, 1958, at 8:00 o'clock A.M. and has been duly recorded in said office in Book No. 8 of Registration Statements on page GR-1687.

~~Construction shall be completed by _____, 19____ and the water completely applied to beneficial use by _____, 19____.~~

Witness my hand this 7th day of January, 1959.

Lewis A. Stanley
(State Engineer)

By _____ (Deputy)

GR-1687

25.00