

SERRA CATHOLIC HIGH SCHOOL
BALL PARK WELL #2

RECEIVED

APR. 7 1958

STATE ENGINEER
SALEM, OREGON

Registration Statement

REGISTRATION NO. GR-1711
CERTIFICATE NO. GR-1688

OF CLAIMANT OF RIGHT TO APPROPRIATE GROUND WATER

(Under Chapter 708, Oregon Laws 1955.)

RECEIVED

JUN 23 1958

STATE ENGINEER
SALEM, OREGON

TO THE STATE ENGINEER OF OREGON:

I, SERRA CATHOLIC HIGH SCHOOL

of SALEM County of MARION

State of OREGON, do hereby make application for a certificate of registration as evidence of a right to appropriate ground water.

1. Source from which water is withdrawn is PUMP WELL #2
(Flowing well, pump well, infiltration trench, or tunnel)

2. Location is: D²/₂ Lancaster East of Salem One 2 Miles
(Approximate distance and direction from nearest city or town)

and is more particularly described as follows: 120 feet east & 720 feet north from S¹/₄ corner Section 19

(a) 1510 ft East & 175' North of SW¹/₄ tract described
(Give distance and bearing to corner of section or other legal subdivision)

being within SE¹/₄ of SW¹/₄ of SE¹/₄ of Sec. 19, Twp. 7S, Rge. 2 W 1 W 4
(Smallest legal subdivision) (N. or S.) (E. or W.)

or (b) within limits of recorded platted property, town or city: _____

in Lot _____, Block _____ of _____
(Name of plat or addition)

County of _____
(If within city or town, give name)

3. Construction Work was begun on 7-2-55, was completed on 7-6-55
(Date) (Date)

and the ground water claimed was first used for the purposes set out below on 7-6-55
(Date)

since which time the water has been used C Intermittently
(Continuously or Intermittently)

from 7-6-55 to Present
(Date) (Date)

4. Quantity of water claimed and used is 200 gallons per minute; 1.5 acre feet per year.

5. Purpose or Purposes for which water is used IRRIGATION - DOMESTIC -

GENERAL PURPOSES

(Domestic, irrigation, municipal, manufacturing, industrial, etc.)

6. Description of Well: Depth 93' feet. Type DRILLED
(Dug or drilled)

diameter 8" - 10 inches. Elevation of ground at well site 207.00 feet, mean sea level.
(As near as known)

Depth to water table 12' feet.

7. Capacity of Well: 10.2 g.p.m. with 31' feet drawdown.

200 g.p.m. with 34' feet drawdown.

Date of test: ON OR ABOUT 7-5-55 BY SHURWAY PUMP CO
SILVERTON ROAD
SALEM, OR

If Flowing Well: Measured discharge _____ g.p.m. on _____
(Date)

Shut-in pressure at ground surface _____ lbs. per sq. in. on _____
(Date)

Water is controlled by _____
(Cap, valve, etc.)

8. Casing: (Give diameter, commercial specifications and depth below ground surface of each casing size.)

8"-1-0 inch diameter 1/2" WALL THICKNESS from 1' to 93' feet
 _____ inch diameter _____ from _____ to _____ feet
 _____ inch diameter _____ from _____ to _____ feet
 _____ inch diameter _____ from _____ to _____ feet

Describe and show depth of shoe, plug, adapter, liner or other details: 8" SPRING STEEL SHOE
WELDED TO BOTTOM OF LOWER JOINT. CASING HAS NO PLUGS
ADAPTERS OR LINERS ATTACHED

9. Perforated Casings or Screens:

10 HOLES PER FT 5" W x 2 1/2" L from 57' to 64'
 (Number per foot and size of perforations, or describe screen)
10 HOLES PER FT 5" W x 2 1/2" L from 80' to 91'
WATER ALSO ENTERS THROUGH BOTTOM OF CASING from 93' to _____
NO SCREEN INSTALLED from _____ to _____

10. Log of Well: (Describe each stratum or formation clearly, indicate if water bearing, and give thickness and depth as indicated.)

MATERIAL	Thickness (Feet)	Depth to Bottom (Feet)
FILL DIRT	1'6"	1'6"
SUBSOIL	2'6"	4'
YELLOW CLAY	16'	20'
BLUE CLAY	16'	36'
FINE BLACK SAND	2'	38'
WATER GRAVEL + SAND	4'	42'
CEMENT GRAVEL	9'	51'
CEMENTED GRAVEL MUCKY SAND BROWN COLOR	4'	55'
BLACK SAND BROWN COLOR CEMENT GRAVEL	4'	59'
WATER CEMENTED GRAVEL	2'	61'
DECOMPOSED VEGETATION	2'	63'
CEMENTED GRAVEL	3'	66'
BLUE SHALE	13'	79'
CEMENTED GRAVEL	13'	92'
WATER GRAVEL	1'	93'

LICENSE # 6


(Length, course, and cross sectional size)

(Make, type and size)

(Type and horsepower)

GR-1688

Township 7 S Range 2 W W.M. 1
North

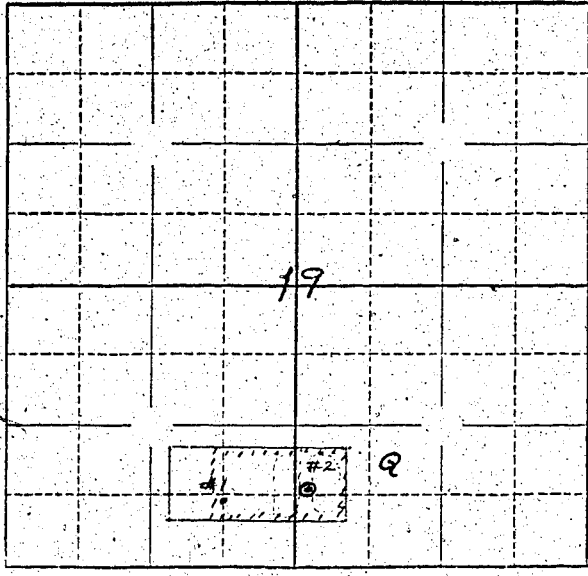

Locate well and acreage of irrigated land on plat.
Scale: 2" = 1 Mile

STATE OF OREGON

County of Marion } ss.

I, R. John Francis de Peralta, being first duly sworn, do hereby certify that I have read the foregoing Registration Statement and that all of the items therein contained are true to the best of my knowledge and belief.

R. John Francis de Peralta
(Signature of Registrant)

Subscribed and sworn to before me this 3 day of April, 1958

My commission expires July 27 1958

Lowell W. Amos
(Notary Public)

(SEAL)

CERTIFICATE OF REGISTRATION

STATE OF OREGON

County of Marion } ss.

This is to certify that the foregoing Registration Statement was received in the office of the State Engineer on the 18th day of June, 1958, at 12:00 o'clock P.M. and has been duly recorded in said office in Book No. 8 of Registration Statements on page GR-1688

~~Construction shall be completed by~~ 10 ~~and the water completely applied to beneficial use by~~ 10

Witness my hand this 7th day of January, 1959

Lowell A. Stanley
(State Engineer)

By _____
(Deputy)

GR-1688

\$25.00