

15.00

Registration No. GR. 1741

Certificate No. GR. 1691

Registration Statement

OF CLAIMANT OF RIGHT TO APPROPRIATE GROUND WATER

TO THE STATE ENGINEER OF OREGON:

I, Bernard F. Schreiner
of Rt 2, Box 297 Salem County of Marion
(Mailing address)

State of Oregon, do hereby make application for a certificate of registration as evidence of a right to appropriate ground water.

1. Source from which water is withdrawn is Well #2
(Flowing well, pump well, infiltration trench, or tunnel)

2. Location is: 2 Miles S.W. Brooks
(Approximate distance and direction from nearest city or town)

and is more particularly described as follows:

(a) 750 E. 2350 S. From N.W. corner Sec 19
(Give distance and bearing to corner of section or other legal subdivision)

being within SW 1/4 NW 1/4 of Sec. 19, Twp. 6 S, Rge. 2 W
(Smallest legal subdivision) (N. or S.) (E. or W.)

or (b) within limits of recorded platted property, town or city:

in Lot _____, Block _____ of _____
(Name of plat or addition)

County of _____
(If within city or town, give name)

3. Construction Work was begun on Feb 3, 1949, was completed on Feb 15, 1949
(Date) (Date)

and the ground water claimed was first used for the purposes set out below on May 1st 1949
(Date)

since which time the water has been used intermittently
(Continuously or intermittently)

from May 1 to Sept 26
(Date) (Date)

4. Quantity of water claimed and used is 100 gallons per minute; _____ acre feet per year.

5. Purpose or Purposes for which water is used irrigating grasses
and Isis and Hemerocallis
(Domestic, irrigation, municipal, manufacturing, industrial, etc.)

6. Description of Well: Depth 110 feet. Type Drilled
(Dug or drilled)

diameter 8 inches. Elevation of ground at well site 185 feet, mean sea level.
(As near as known)

Depth to water table 32 feet.

7. Capacity of Well: 200 g.p.m. with 30 feet drawdown.

_____ g.p.m. with _____ feet drawdown.


Date of test estimated

If Flowing Well: Measured discharge _____ g.p.m. on _____
(Date)

Shut-in pressure at ground surface _____ lbs. per sq. in. on _____
(Date)

Water is controlled by _____
(Cap, valve, etc.)

Township 9S Range 2W W.M.
North

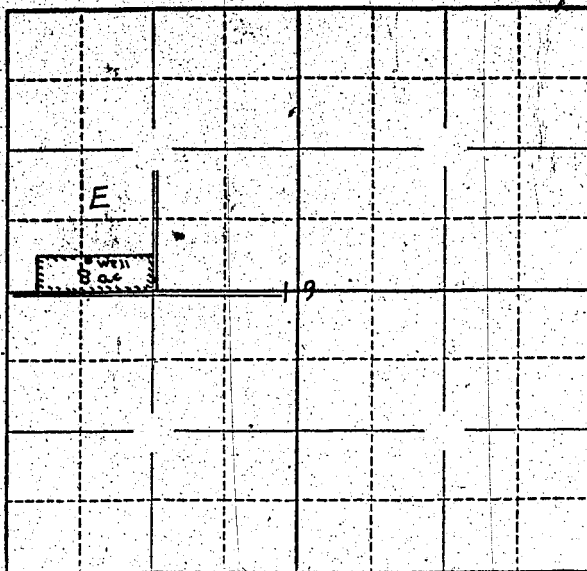

Locate well and acreage of irrigated land on plat.
Scale: 2" = 1 Mile

STATE OF OREGON

County of Marion } ss.

I, Bernard F. Schreiner, being first duly sworn, do hereby certify that I have read the foregoing Registration Statement and that all of the items therein contained are true to the best of my knowledge and belief.

Bernard F. Schreiner
(Signature of Registrant)

Subscribed and sworn to before me this 18th day of June, 1958

My commission expires 12th June 1961

Wm. S. Bartholomew
(Notary Public)

(SEAL)

CERTIFICATE OF REGISTRATION

STATE OF OREGON

County of Marion } ss.

This is to certify that the foregoing Registration Statement was received in the office of the State Engineer on the 18th day of June, 1958, at 9:00 o'clock A. M. and has been duly recorded in said office in Book No. 8 of Registration Statements on page GR 1691

Witness my hand this 7th day of January, 1959

Lewis A. Stanley
(State Engineer)

By _____

(Deputy)

GR 1691

#1500