

RECEIVED  
JUN 19 1958  
STATE ENGINEER  
SALEM, OREGON

Registration No. GR - 1717  
Certificate No. GR 1694

### Registration Statement

#### OF CLAIMANT OF RIGHT TO APPROPRIATE GROUND WATER

TO THE STATE ENGINEER OF OREGON:

I, Lynn Brooks

of 1810 Pacific Ave Forest Grove County of Washington

State of Oregon, do hereby make application for a certificate of registration as evidence of a right to appropriate ground water.

1. Source from which water is withdrawn is Pump Well  
(Flowing well, pump well, infiltration trench, or tunnel)

2. Location is: Cornelius Oregon  
(Approximate distance and direction from nearest city or town)

and is more particularly described as follows:

(a) 548° 0' W 1700' from NE Corner Sec 4  
(Give distance and bearing to corner of section or other legal subdivision)

being within NE 1/4 of NE 1/4 of Sec. 4, Twp. 1-S, Rge. 3-W  
(Smallest legal subdivision) (N. or S.) (E. or W.)

or (b) within limits of recorded platted property, town or city: Cornelius

in Lot \_\_\_\_\_, Block 4 of Henry's Addition  
(Name of plat or addition)

Cornelius County of Washington  
(If within city or town, give name)

3. Construction Work was begun on 1942; was completed on 1942  
(Date) (Date)

and the ground water claimed was first used for the purposes set out below on 1942  
(Date)

since which time the water has been used Intermittently  
(Continuously or Intermittently)

from June to September  
(Date) (Date)

4. Quantity of water claimed and used is 15 gallons per minute; 3.75 acre feet per year.

5. Purpose or Purposes for which water is used IRRIGATION  
(Domestic, irrigation, municipal, manufacturing, industrial, etc.)

6. Description of Well: Depth 60 feet. Type Drilled  
(Dug or drilled)

diameter 6 inches. Elevation of ground at well site \_\_\_\_\_ feet, mean sea level.  
(As near as known)

Depth to water table 10 feet.

7. Capacity of Well: 15 g.p.m. with 10 feet drawdown.

\_\_\_\_\_ g.p.m. with \_\_\_\_\_ feet drawdown.

Date of test \_\_\_\_\_

If Flowing Well: Measured discharge \_\_\_\_\_ g.p.m. on \_\_\_\_\_  
(Date)

Shut-in pressure at ground surface \_\_\_\_\_ lbs. per sq. in. on \_\_\_\_\_  
(Date)

Water is controlled by \_\_\_\_\_  
(Cap, valve, etc.)

8. Casing: (Give diameter, commercial specifications and depth below ground surface of each casing size.)

6 inch diameter *Steel* from 0 to 60 feet  
\_\_\_\_ inch diameter \_\_\_\_\_ from \_\_\_\_\_ to \_\_\_\_\_ feet  
\_\_\_\_ inch diameter \_\_\_\_\_ from \_\_\_\_\_ to \_\_\_\_\_ feet  
\_\_\_\_ inch diameter \_\_\_\_\_ from \_\_\_\_\_ to \_\_\_\_\_ feet

Describe and show depth of shoe, plug, adapter, liner or other details: \_\_\_\_\_  
*None*

9. Perforated Casings or Screens:

*None* from \_\_\_\_\_ to \_\_\_\_\_  
(Number per foot and size of perforations, or describe screen)  
\_\_\_\_ from \_\_\_\_\_ to \_\_\_\_\_  
\_\_\_\_ from \_\_\_\_\_ to \_\_\_\_\_  
\_\_\_\_ from \_\_\_\_\_ to \_\_\_\_\_

10. Log of Well: (Describe each stratum or formation clearly, indicate if water bearing, and give thickness and depth as indicated.)

MATERIAL	Thickness (Feet)	Depth to Bottom (Feet)
<i>None available</i>		

If log of well is not available, give name and address of driller. Baseline Drilling Co.  
Hillsboro, Ore.

11. Infiltration Trench: Covered or open \_\_\_\_\_  
 Dimensions: Length \_\_\_\_\_ ft. Minimum depth \_\_\_\_\_ ft. Maximum depth \_\_\_\_\_ ft.  
 Bottom width \_\_\_\_\_ ft. Discharge \_\_\_\_\_ g.p.m. Date of test \_\_\_\_\_

12. Tunnel: Type of lining \_\_\_\_\_  
 Dimensions: \_\_\_\_\_  
(Length, course, and cross sectional size)  
 Position of water bearing stratum with reference to portal of tunnel \_\_\_\_\_

Log of tunnel: (Preceding table for log of well may be used, if desired. Give footage from portal and character of materials, as pertinent.)


13. Pumping Equipment:  
 (a) Pump Myers Jet Capacity 20 g.p.m.  
(Make, type and size)  
 (b) Motor 1 HP Electric Motor  
(Type and horsepower)

14. Location of area irrigated or to be irrigated, or place of use if for purposes other than irrigation.

Township North or South	Range E. or W. of Willamette Meridian	Section	Four-acre Tract	Number Acres To Be Irrigated	Date of Reclamation
15	3W	4	NE 1/4 of NE 1/4	1.0	1942
15	3W	4	SE 1/4 of NE 1/4	0.5	1942
				<u>1.5</u>	

15. If the ground water supply is supplemental to an existing water supply, identification of any application for a permit, permit, certificate or adjudicated right to appropriate water made or held by the registrant.  
Name

Township 15 Range 3W W.M.  
North

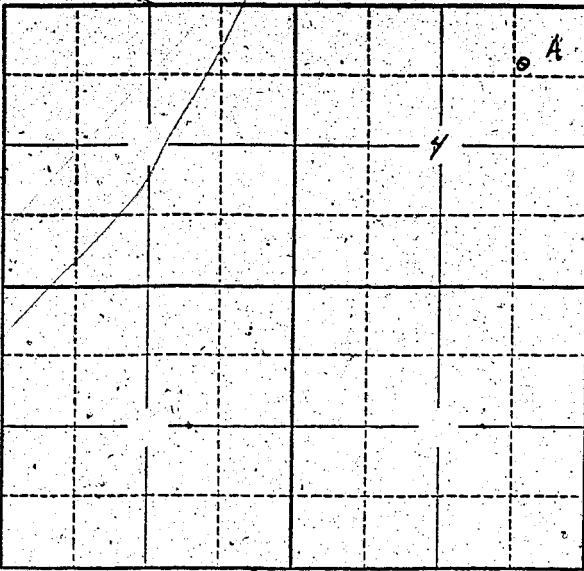

Locate well and acreage of irrigated land on plat.  
Scale: 2" = 1 Mile

STATE OF OREGON

County of Marion } ss.

I, Lyman Brooks, being first duly sworn, do hereby certify that I have read the foregoing Registration Statement and that all of the items therein contained are true to the best of my knowledge and belief.

Lyman Brooks  
(Signature of Registrant)

Subscribed and sworn to before me this 26th day of March, 1958

My commission expires 12th June 1961

Wm. S. Bartholomew  
(Notary Public)

(SEAL)

**CERTIFICATE OF REGISTRATION**

STATE OF OREGON

County of Marion } ss.

This is to certify that the foregoing Registration Statement was received in the office of the State Engineer on the 19th day of June, 1958, at 8:00 o'clock A. M. and has been duly recorded in said office in Book No. 8 of Registration Statements on page GR-1694

Witness my hand this 7th day of January, 1959

Lawrence A. Ottaway  
(State Engineer)

By \_\_\_\_\_  
(Deputy)

\$15.00

GR-1694