

Registration Statement

OF CLAIMANT OF RIGHT TO APPROPRIATE GROUND WATER

(Under Chapter 708, Oregon Laws 1955.)

TO THE STATE ENGINEER OF OREGON:

I, Joseph N. Hershberger
of Canby County of Clackamas
State of Oregon, do hereby make application for a certificate of registration as evidence of a right to appropriate ground water.

1. Source from which water is withdrawn is pump well
(Flowing well, pump well, infiltration trench, or tunnel)
2. Location is: Approximately 1 1/2 miles east and slightly north of Aurora, Ore.
(Approximate distance and direction from nearest city or town)

and is more particularly described as follows:

(a) 1760' West & 1590' North from SE corner Section 7
(Give distance and bearing to corner of section or other legal subdivision)
being within NW 1/4 of SE 1/4 Tax lot 49 of Sec. 7, Twp. 4 S, Rge. 1 E
(Smallest legal subdivision) (N. or S.) (E. or W.)

or (b) within limits of recorded platted property, town or city:

in Lot _____, Block _____ of _____
(Name of plat or addition)
County of Clackamas
(If within city or town, give name)

3. Construction Work was begun on June 11, 1946; was completed on June 13, 1946
(Date) (Date)
and the ground water claimed was first used for the purposes set out below on July 1, 1946
(Date)
since which time the water has been used continuously
(Continuously or intermittently)
from July 1, 1946 to Oct. 1957
(Date) (Date)

4. Quantity of water claimed and used is 120 gallons per minute; _____ acre feet per year.

5. Purpose or Purposes for which water is used household and irrigation, 15 acres
(Domestic, irrigation, municipal, manufacturing, industrial, etc.)

6. Description of Well: Depth 101 feet. Type drilled
(Dug or drilled)
diameter 6 inches. Elevation of ground at well site 150 feet, mean sea level.
(As near as known)
Depth to water table 65 feet.

7. Capacity of Well: 120 or more g.p.m. with 15 feet drawdown.
_____ g.p.m. with _____ feet drawdown.


Date of test 6-13-1946

If Flowing Well: Measured discharge _____ g.p.m. on _____
(Date)

Shut-in pressure at ground surface _____ lbs. per sq. in. on _____
(Date)

Water is controlled by _____
(Cap, valve, etc.)

Township 45 Range 1E W.M.
North

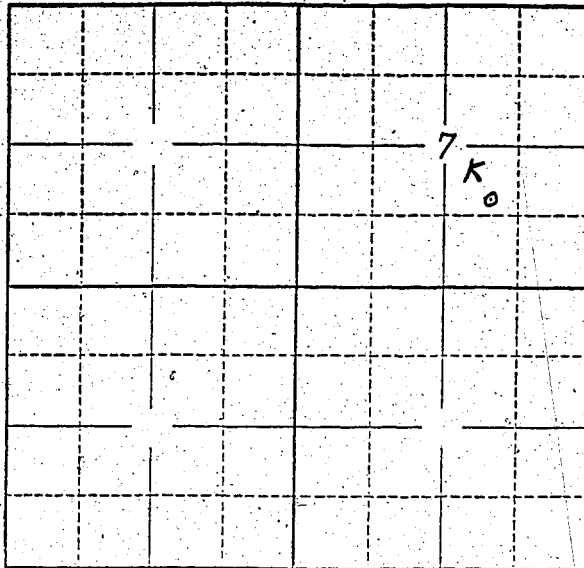

Locate well and acreage of irrigated land on plat.
Scale: 2" = 1 Mile

STATE OF OREGON

County of _____ } ss.

I, _____, being first duly sworn, do hereby certify that I have read the foregoing Registration Statement and that all of the items therein contained are true to the best of my knowledge and belief.

Joseph N. Newberry
(Signature of Registrant)

Subscribed and sworn to before me this 19th day of June, 1958.

My commission expires July 24, 1961
(Notary Public)

(SEAL)

CERTIFICATE OF REGISTRATION

STATE OF OREGON

County of Marion } ss.

This is to certify that the foregoing Registration Statement was received in the office of the State Engineer on the 19th day of June, 1958, at 10:30 o'clock A. M. and has been duly recorded in said office in Book No. 8 of Registration Statements on page GR-1696

~~Construction shall be completed by _____ and the water completely applied to beneficial use by _____~~

Witness my hand this 7th day of January, 1959.

Lewis A. Stanley
(State Engineer)

\$15.00

By _____ (Deputy)

GR-1696