

Registration Statement

OF CLAIMANT OF RIGHT TO APPROPRIATE GROUND WATER

TO THE STATE ENGINEER OF OREGON:

I, Edd Hobson
of Stayton Ore County of Lincoln
(Mailing address)

State of Oregon, do hereby make application for a certificate of registration as evidence of a right to appropriate ground water.

1. Source from which water is withdrawn is Well # 2
(Flowing well, pump well, infiltration trench, or tunnel)

2. Location is: 1 mile south of Stayton
(Approximate distance and direction from nearest city or town)

and is more particularly described as follows:

(a) 700 feet west & 300 feet north from S 1/4 corner Section 15
(Give distance and bearing to corner of section or other legal subdivision)

being within SE 1/4 of SW 1/4 of Sec. 15, Twp. 9S, Rge. 10W
(Smallest legal subdivision) (S. or E.) (E. or W.)

or (b) within limits of recorded platted property, town or city:

in Lot _____, Block _____ of _____
(Name of plat or addition)

County of _____
(If within city or town, give name)

3. Construction Work was begun on May 15 54; was completed on May 1954
(Date) (Date)

and the ground water claimed was first used for the purposes set out below on May 15 54
(Date)

since which time the water has been used intermittently during season
(Continuously or intermittently)

from May 54 to Oct 1957
(Date) (Date)

4. Quantity of water claimed and used is 300 gallons per minute; 68 acre feet per year.

5. Purpose or Purposes for which water is used irrigation

(Domestic, irrigation, municipal, manufacturing, industrial, etc.)

6. Description of Well: Depth 15 feet. Type drilled
(Dug or drilled)

diameter 8 inches. Elevation of ground at well site 0 feet, mean sea level.
(As near as known)

Depth to water table 12 feet.

7. Capacity of Well: 300 g.p.m. with 15 feet drawdown.

_____ g.p.m. with _____ feet drawdown.


Date of test _____

If Flowing Well: Measured discharge _____ g.p.m. on _____
(Date)

Shut-in pressure at ground surface _____ lbs. per sq. in. on _____
(Date)

Water is controlled by _____
(Cap, valve, etc.)

Township 95 Range 1W, W.M.
North

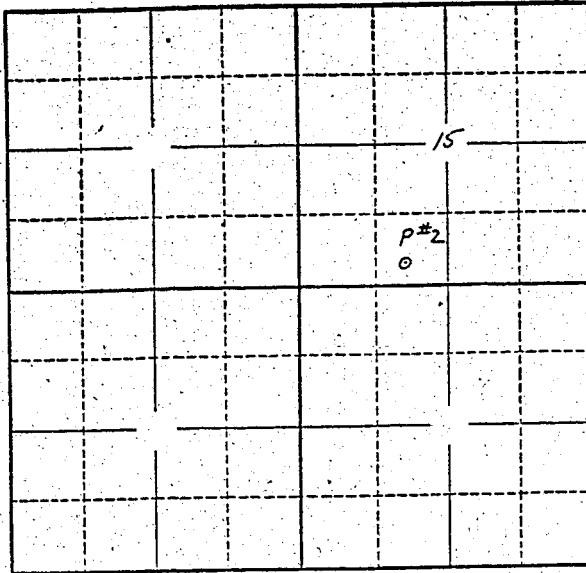

Locate well and acreage of irrigated land on plat.
Scale: 2" = 1 Mile

STATE OF OREGON

County of Marion } ss.

I, _____, being first duly sworn, do hereby certify that I have read the foregoing Registration Statement and that all of the items therein contained are true to the best of my knowledge and belief.

Edd Hobson
(Signature of Registrant)

Subscribed and sworn to before me this 19th day of June, 19 58

My commission expires 12th June 1961

Wm. S. Bartholomew
(Notary Public)

(SEAL)

CERTIFICATE OF REGISTRATION

STATE OF OREGON

County of Marion } ss.

This is to certify that the foregoing Registration Statement was received in the office of the State Engineer on the 19th day of June, 19 58, at 12:00 o'clock A. M. and has been duly recorded in said office in Book No. 8 of Registration Statements on page GR-1698

Witness my hand this 7th day of January, 19 59

Lewis J. Strubley
(State Engineer)

By _____

(Deputy)

\$ 15.60

GR-1698