

#1500  
**RECEIVED**

JUN 20 1958

STATE ENGINEER  
SALEM, OREGON

Registration No. GR-1754

Certificate No. GR-1701

### Registration Statement

#### OF CLAIMANT OF RIGHT TO APPROPRIATE GROUND WATER

TO THE STATE ENGINEER OF OREGON:

I, Yancy McGill  
of Turner Rt 1 Box 117 County of Mason  
(Mailing address)

State of Oregon, do hereby make application for a certificate of registration as evidence of a right to appropriate ground water.

1. Source from which water is withdrawn is Pump Well  
(Spring well, pump well, infiltration trench, or tunnel)
2. Location is: 2 1/4 E. of Jefferson  
(Approximate distance and direction from nearest city or town)

and is more particularly described as follows:

(a) 750' S & 400' E from 1/4 Corner on W Line Sec 18  
(Give distance and bearing to corner of section or other legal subdivision)

being within NW 1/4 SW of Sec. 18, Twp. 10 S, Rge. 2 W  
(Smallest legal subdivision) (N. or S.) (E. or W.)

or (b) within limits of recorded platted property, town or city:  
in Lot \_\_\_\_\_, Block \_\_\_\_\_ of \_\_\_\_\_  
(Name of plat or addition)

(If within city or town, give name) County of \_\_\_\_\_

3. Construction Work was begun on 1937 approximately 20 years ago; was completed on 1937  
(Date) (Date)

and the ground water claimed was first used for the purposes set out below on 1937  
(Date)

since which time the water has been used Intermittently  
(Continuous or intermittently)

from 1937 to 1957  
(Date) (Date)

4. Quantity of water claimed and used is 100 gallons per minute; 15 acre feet per year.

5. Purpose or Purposes for which water is used IRRIGATION  
(Domestic, irrigation, municipal, manufacturing, industrial, etc.)

6. Description of Well: Depth 21 feet. Type 8 in drilled  
(Dug or drilled)

diameter 8 inches. Elevation of ground at well site Approx. 250 feet, mean sea level.  
(As near as known)

Depth to water table about 15 feet.

7. Capacity of Well: 400 g.p.m. with \_\_\_\_\_ feet drawdown.  
\_\_\_\_\_ g.p.m. with \_\_\_\_\_ feet drawdown.

Date of test \_\_\_\_\_

If Flowing Well: Measured discharge \_\_\_\_\_ g.p.m. on \_\_\_\_\_  
(Date)


Shut-in pressure at ground surface \_\_\_\_\_ lbs. per sq. in. on \_\_\_\_\_  
(Date)

Water is controlled by \_\_\_\_\_  
(Cap, valve, etc.)





Township 105 Range 2W W.M.  
North

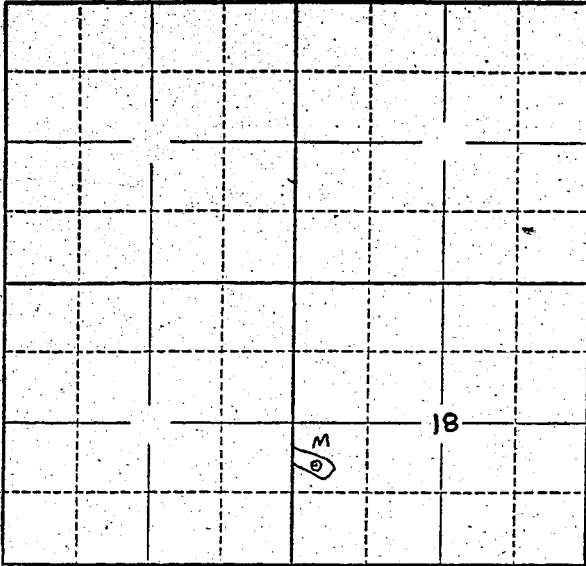

Locate well and acreage of irrigated land on plat.  
Scale: 2" = 1 Mile

STATE OF OREGON  
County of Marion } ss.

I, Y. M. Mc Lee, being first duly sworn, do hereby certify that I have read the foregoing Registration Statement and that all of the items therein contained are true to the best of my knowledge and belief.

Y. M. Mc Lee  
(Signature of Registrant)

Subscribed and sworn to before me this 13<sup>th</sup> day of June, 1957

Edw. J. Bee  
(Notary Public)

My commission expires \_\_\_\_\_

(SEAL)

**CERTIFICATE OF REGISTRATION**

STATE OF OREGON }  
County of Marion } ss.

This is to certify that the foregoing Registration Statement was received in the office of the State Engineer on the 20<sup>th</sup> day of June, 1958, at 8:00 o'clock A. M. and has been duly recorded in said office in Book No. 8 of Registration Statements on page GR-1701

Witness my hand this 7<sup>th</sup> day of January, 1959

Lewis A. Stanley  
(State Engineer)

\$15.00

By \_\_\_\_\_  
(Deputy)

GR - 1701