

Registration Statement CERTIFICATE NO. GR-3804

OF CLAIMANT OF RIGHT TO APPROPRIATE GROUND WATER

(Under Chapter 708, Oregon Laws 1955.)

TO THE STATE ENGINEER OF OREGON:

I, John G. or Frances E. Lamb of Creswell County of Lane State of Oregon

do hereby make application for a certificate of registration as evidence of a right to appropriate ground water.

1. Source from which water is withdrawn is Pump well (Flowing well, pump well, infiltration trench, or tunnel)

2. Location is: 2 miles South of Creswell (Approximate distance and direction from nearest city or town)

and is more particularly described as follows:

(a) 1150 feet west & 160 feet North from E 1/4 corner Section 26 (Give distance and bearing to corner of section or other legal subdivision)

being within T 36 SE 1/4 of the NE 1/4 of Sec. 26 Twp. 19 S Rge. 3 W 11 (Smallest legal subdivision) (N. or S.) (E. or W.)

or (b) within limits of recorded platted property, town or city:

in Lot 2, Block of Village Station located on Creswell Lane County of Lane (Name of plat or addition)

(If within city or town, give name) County of Lane

3. Construction Work was begun on March 1953, was completed on April 1953 (Date) (Date)

and the ground water claimed was first used for the purposes set out below on 1953 (Date)

since which time the water has been used Continuously or Intermittently

from June 1953 to (Date) (Date)

4. Quantity of water claimed and used is 60 gallons per minute; acre feet per year.

5. Purpose or Purposes for which water is used (Domestic, irrigation, municipal, manufacturing, industrial, etc.)

6. Description of Well: Depth 35 feet. Type (Dug or drilled)

diameter 5 inches. Elevation of ground at well site feet, mean sea level. (As near as known)

Depth to water table feet.

7. Capacity of Well: g.p.m. with feet drawdown. g.p.m. with feet drawdown.

Date of test

If Flowing Well: Measured discharge g.p.m. on (Date)


Shut-in pressure at ground surface lbs. per sq. in. on (Date)

Water is controlled by (Gate, valve, etc.)





Township 19S Range 3W W.M.  
North

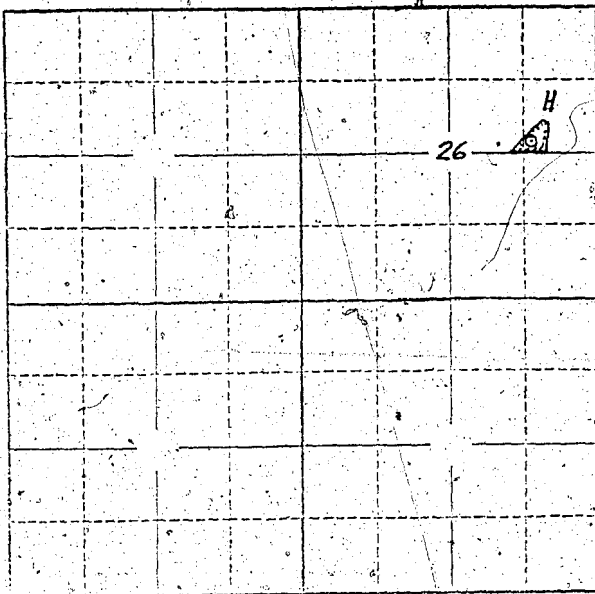

Locate well and acreage of irrigated land on plat.  
Scale: 2" = 1 Mile

STATE OF OREGON

County of Lane } ss.

I, John G. Lamb, being first duly sworn, do hereby certify that I have read the foregoing Registration Statement and that all of the items therein contained are true to the best of my knowledge and belief.

Subscribed and sworn to before me this 19th day of June, 1958

My commission expires June 30, 1961

(SEAL)

John G. Lamb  
(Signature of Registrant)

June H. Bird  
(Notary Public)

**CERTIFICATE OF REGISTRATION**

STATE OF OREGON } ss.  
County of Marion

This is to certify that the foregoing Registration Statement was received in the office of the State Engineer on the 23rd day of June, 1958, at 8 o'clock A. M. and has been duly recorded in said office in Book No. 16 of Registration Statements on page GR-3804

~~XX Construction shall be completed by \_\_\_\_\_ and the water completely applied to \_\_\_\_\_~~

~~\_\_\_\_\_~~ XX

Witness my hand this 4th day of December, 1959

Wm. J. Stanley  
(State Engineer)

\$15.00

By \_\_\_\_\_ (Deputy)  
GR-3804