

\$1500
State Engineer
Salem Oregon

RECEIVED
JAN 2 1958
STATE ENGINEER
SALEM OREGON

Registration No. GR-1762
Certificate No. GR 1714

Registration Statement

OF CLAIMANT OF RIGHT TO APPROPRIATE GROUND WATER

TO THE STATE ENGINEER OF OREGON:

I, Wesley B. Kenyon
of 1701 - Lexington Junction City County of Lane
(Mailing address)
State of Oregon, do hereby make application for a certificate of registration as evidence of a right to appropriate ground water.

- Source from which water is withdrawn is Pump Well
(Flowing well, pump well, infiltration trench, or funnel)
- Location is: 4 miles NW of Junction City
(Approximate distance and direction from nearest city or town)

and is more particularly described as follows:

(a) 1840' E 510' S from NW CORNER SEC 19
(Give distance and bearing to corner of section or other legal subdivision)
being within NE/NW of Sec. 19, Twp. 15 S, Rge. 4 W - W 11
(Smallest legal subdivision) (N. or S.) (E. or W.)

or (b) within limits of recorded platted property, town or city: no
in Lot _____, Block _____ of _____
(Name of plat or addition)
County of _____
(If within city or town, give name)

3. Construction Work was begun on 1946; was completed on 1946
(Date) (Date)
and the ground water claimed was first used for the purposes set out below on June 1946
(Date)

since which time the water has been used During the Summers
(Continuously or intermittently)
from May to Oct
(Date) (Date)

4. Quantity of water claimed and used is 120 gallons per minute; 30 acre feet per year.


5. Purpose or Purposes for which water is used Irrigation
(Domestic, irrigation, municipal, manufacturing, industrial, etc.)

6. Description of Well: Depth 70 feet. Type Drilled
(Dug or drilled)
diameter 5 inches. Elevation of ground at well site 700 feet, mean sea level.
(As near as known)
Depth to water table 5 feet.

7. Capacity of Well: _____ g.p.m. with _____ feet drawdown.
_____ g.p.m. with _____ feet drawdown.

Date of test _____
If Flowing Well: Measured discharge _____ g.p.m. on _____
(Date)
Shut-in pressure at ground surface _____ lbs. per sq. in. on _____
(Date)
Water is controlled by _____
(Cap, valve, etc.)

Township 165 Range 4W, W.M.
North

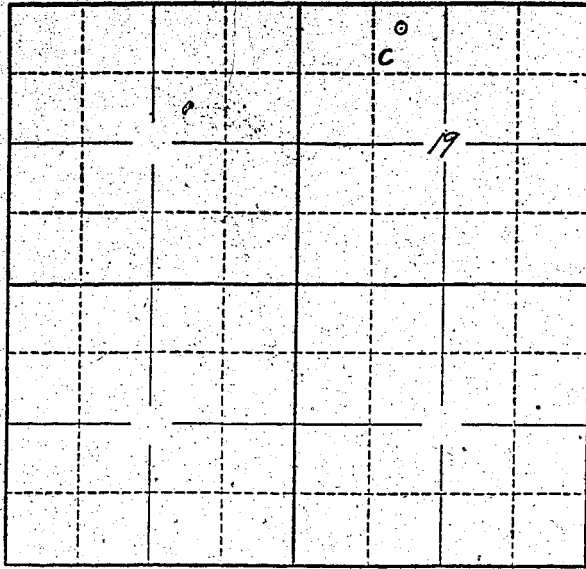

Locate well and acreage of irrigated land on plat.
Scale: 2" = 1 Mile

STATE OF OREGON

County of Lane } ss.

I, VIRGIL B. KENYON, being first duly sworn, do hereby certify that I have read the foregoing Registration Statement and that all of the items therein contained are true to the best of my knowledge and belief.

Virgil B. Kenyon
(Signature of Registrant)

Subscribed and sworn to before me this 14th day of March, 1958

My commission expires June 25, 1961 Lula A. Hansen
(Notary Public)

(SEAL)

CERTIFICATE OF REGISTRATION

STATE OF OREGON

County of Marion } ss.

This is to certify that the foregoing Registration Statement was received in the office of the State Engineer on the 23rd day of June, 1958, at 8.00 o'clock A. M. and has been duly recorded in said office in Book No. 8 of Registration Statements on page GR-1714

Witness my hand this 7th day of January, 1959

Lewis A. Stanley
(State Engineer)

By _____
(Deputy)

\$15.00