

RECEIVED
MAY 9 1956
STATE ENGINEER
SALEM, OREGON

REGISTRATION NO. GR-177

Registration Statement

CERTIFICATE NO. GR-313

OF CLAIMANT OF RIGHT TO APPROPRIATE GROUND WATER

(Under Chapter 708, Oregon Laws 1955.)

TO THE STATE ENGINEER OF OREGON:

I, Ray C. Batterton

of Route 3 Junction City County of Lane

State of Oregon, do hereby make application for a certificate of registration as evidence of a right to appropriate ground water:

1. Source from which water is withdrawn is Pump Well No. 2
(Flowing well, pump well, infiltration trench, or tunnel)

2. Location is: 3.0 miles North of Junction City
(Approximate distance and direction from nearest city or town)

and is more particularly described as follows:

(a) West 3044.4 and South 1910.0 from N.E. corner Sec. 17
(Give distance and bearing to corner of section or other legal subdivision)

being within S.E. 1/4 of N.W. 1/4 of Sec. 17, Twp. 15.S., Rge. 4.W.
(Smallest legal subdivision) (N. of S.) (E. or W.)

or (b) within limits of recorded platted property, town or city: Flat of Noraton

in Lot 10, Block _____ of Noraton
(Name of plat or addition)

County of Lane
(If within city or town, give name)

3. Construction Work was begun on 1952; was completed on 1952
(Date) (Date)

and the ground water claimed was first used for the purposes set out below on 1952
(Date)

since which time the water has been used Continuously during growing season
(Continuously or intermittently)

from 1952 to 1956
(Date) (Date)

4. Quantity of water claimed and used is 200 gallons per minute; _____ acre feet per year.

5. Purpose or Purposes for which water is used Crop Irrigation

(Domestic, irrigation, municipal, manufacturing, industrial, etc.)

6. Description of Well: Depth 22 feet. Type Driven
(Dug or drilled)

diameter 4 inches. Elevation of ground at well site 325.0 feet, mean sea level.
(As near as known)

Depth to water table 14 feet.

7. Capacity of Well unknown g.p.m. with unknown feet drawdown.

_____ g.p.m. with _____ feet drawdown.


Date of test _____

If Flowing Well: Measured discharge _____ g.p.m. on _____
(Date)

Shut-in pressure at ground surface _____ lbs. per sq. in. on _____
(Date)

Water is controlled by _____
(Cap, valve, etc.)

Township 10.S. Range 4.W. W.M.
North

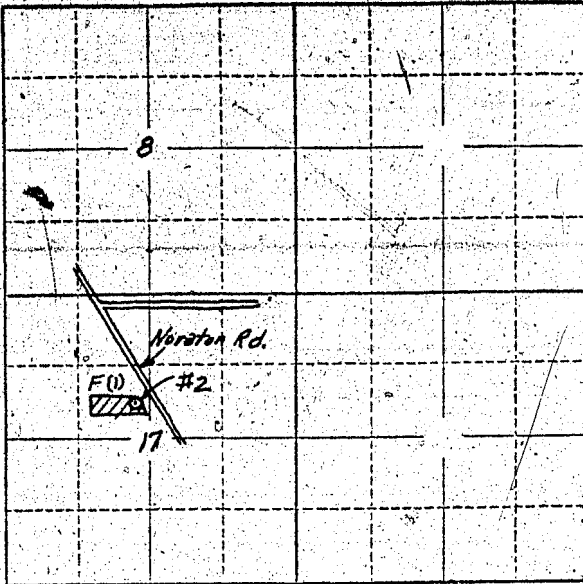

Locate well and acreage of irrigated land on plat.
Scale: 2" = 1 Mile

STATE OF OREGON

County of Linn

} ss.

I, Roy C. Betterton, being first duly sworn, do hereby certify that I have read the foregoing Registration Statement and that all of the items therein contained are true to the best of my knowledge and belief.

Roy C. Betterton
(Signature of Registrant)

Subscribed and sworn to before me this 8th day of May, 19 56.

My commission expires August 13, 1958

Wm. C. DeLoe
(Notary Public) -
Notary Public for Oregon

(SEAL)

CERTIFICATE OF REGISTRATION

STATE OF OREGON

County of Marion

} ss.

This is to certify that the foregoing Registration Statement was received in the office of the State Engineer on the 9th day of May, 19 56 at 8:00 o'clock A. M. and has been duly recorded in said office in Book No. 2 of Registration Statements on page GR-313 C

~~Construction shall be completed by 10-1-58 and the water therefrom shall be beneficially used by 10-1-58~~

Witness my hand this 1st day of April, 19 57

Leuro A. Stanley
(State Engineer)

By _____
(Deputy)

GR-313C

4.15.00