

RECEIVED  
JUN 21 1958  
STATE ENGINEER  
SALEM, OREGON

Registration No. GR. 1271

Certificate No. GR. 1716

# Registration Statement

## OF CLAIMANT OF RIGHT TO APPROPRIATE GROUND WATER

TO THE STATE ENGINEER OF OREGON:

I, Edward K. Vaughan

of 737 North 31st, Corvallis County of Benton  
(Mailing address)

State of Oregon, do hereby make application for a certificate of registration as evidence of a right to appropriate ground water.

1. Source from which water is withdrawn is pump well  
(Flowing well, pump well, infiltration trench, or tunnel)

2. Location is: 2 miles NE of Corvallis  
(Approximate distance and direction from nearest city or town)

and is more particularly described as follows: 182' S 33° 10' W to iron pipe located 3.068 chains N 1° 07' W from SW corner of tract of land conveyed to John Palmer by deed  
(a) recorded in Book 77, page 178, Benton County, Oregon in Sec 19 T 11S R 1W well  
(Give distance and bearing to corner of section or other legal subdivision)

being within NE 1/4 SW 1/4 of Sec. 19, Twp. 11S, Rge. 1W, W.M.  
(Smallest legal subdivision) (N. or S.) (E. or W.)

or (b) within limits of recorded platted property, town or city:

in Lot \_\_\_\_\_, Block \_\_\_\_\_ of \_\_\_\_\_  
(Name of plat or addition)

County of \_\_\_\_\_  
(If within city or town, give name)

3. Construction Work was begun on March, 1951; was completed on 1951  
(Date) (Date)

and the ground water claimed was first used for the purposes set out below on 1951  
(Date)

since which time the water has been used continuously  
(Continuously or intermittently)

from 1951 to 1958  
(Date) (Date)

4. Quantity of water claimed and used is 50 when pumping gallons per minute; 20 acre feet per year.

5. Purpose or Purposes for which water is used irrigation, also used for domestic purposes  
(Domestic, irrigation, municipal, manufacturing, industrial, etc.)

6. Description of Well: Depth 51 feet. Type drilled  
(Dug or drilled)

diameter 6 inches. Elevation of ground at well site 230 feet, mean sea level.  
(As near as known)

Depth to water table 30 feet.

7. Capacity of Well untested, in excess of 60 gpm g.p.m. with \_\_\_\_\_ feet drawdown.  
\_\_\_\_\_ g.p.m. with \_\_\_\_\_ feet drawdown.

Date of test \_\_\_\_\_

If Flowing Well: Measured discharge \_\_\_\_\_ g.p.m. on \_\_\_\_\_  
(Date)

Shut-in pressure at ground surface \_\_\_\_\_ lbs. per sq. in. on \_\_\_\_\_  
(Date)

Water is controlled by \_\_\_\_\_  
(Cap, valve, etc.)

8. **Casing:** (Give diameter, commercial specifications and depth below ground surface of each casing size.)

6 inch diameter steel from surface to 51 feet  
inch diameter from to feet  
inch diameter from to feet  
inch diameter from to feet

Describe and show depth of shoe, plug, adapter, liner or other details:

9. **Perforated Casings or Screens:**

perforated from 10 to 51  
(Number per foot and size of perforations, or describe screen)  
from to  
from to  
from to

10. **Log of Well:** (Describe each stratum or formation clearly, indicate if water bearing, and give thickness and depth as indicated.)

MATERIAL	Thickness (Feet)	Depth to Bottom (Feet)
<u>unknown</u>		

If log of well is not available, give name and address of driller. ....

11. Infiltration Trench: Covered or open .....

Dimensions: Length ..... ft. Minimum depth ..... ft. Maximum depth ..... ft.

Bottom width ..... ft. Discharge ..... g.p.m. Date of test .....

12. Tunnel: Type of lining .....

Dimensions: .....  
(Length, course, and cross sectional size)

Position of water bearing stratum with reference to portal of tunnel .....

Log of tunnel: (Preceding table for log of well may be used, if desired. Give footage from portal and character of materials, as pertinent.)

13. Pumping Equipment:

(a) Pump Fairbanks Morse shaft driven, turbine Capacity 60 g.p.m.  
(Make, type and size)


(b) Motor 3 hp electric, single phase  
(Type and horsepower)

14. Location of area irrigated or to be irrigated, or place of use if for purposes other than irrigation.

Township North or South	Range E. or W. of Willamette Meridian	Section	Forty-acre Tract	Number Acres To Be Irrigated	Date of Reclamation
11S	6W	19	SE 1/4 SW 1/4	4.0	1951
11S	6W	19	NE 1/4 SW 1/4	4.2	1951
Total:				8.2	

15. If the ground water supply is supplemental to an existing water supply, identification of any application for a permit, permit, certificate or adjudicated right to appropriate water made or held by the registrant.

Township 11S Range 4W, W.M.  
North

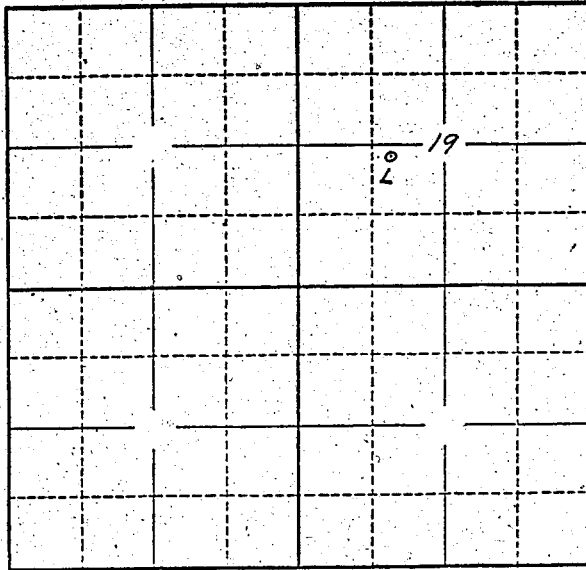

Locate well and acreage of irrigated land on plat.  
Scale: 2" = 1 Mile

STATE OF OREGON }  
County of Benton } ss.

I, Edmond K. Vaughan, being first duly sworn, do hereby certify that I have read the foregoing Registration Statement and that all of the items therein contained are true to the best of my knowledge and belief.

Edmond K. Vaughan  
(Signature of Registrant)

Subscribed and sworn to before me this 20 day of June, 1958

My commission expires NOTARY PUBLIC FOR OREGON  
MY COMMISSION EXPIRES NOV. 16, 1961

Ernst Schumacher  
(Notary Public)

(SEAL)

**CERTIFICATE OF REGISTRATION**

STATE OF OREGON }  
County of Marion } ss.

This is to certify that the foregoing Registration Statement was received in the office of the State Engineer on the 23rd day of June, 1958, at 8.00 o'clock A.M. and has been duly recorded in said office in Book No. 8 of Registration Statements on page GR-1716

Witness my hand this 7th day of January, 1959

Lewis A. Stanley  
(State Engineer)

\$15.00

By \_\_\_\_\_  
(Deputy)

GR-1716