

Registration Statement

OF CLAIMANT OF RIGHT TO APPROPRIATE GROUND WATER

(Under Chapter 703, Oregon Laws 1955.)

TO THE STATE ENGINEER OF OREGON:

I, Herbert Pearsonof Route 2, Corvallis County of BentonState of Oregon, do hereby make application for a certificate of registration as evidence of a right to appropriate ground water.1. Source from which water is withdrawn is pump well
(Flowing well, pump well, infiltration trench, or tunnel)2. Location is: 5 miles south of Philomath
(Approximate distance and direction from nearest city or town)

and is more particularly described as follows:

(a) 1584' east and 420 south from the NW corner of Section 2
(Give distance and bearing to corner of section or other legal subdivision)being within NE 1/4 NW 1/4 of Sec. 2, Twp. 13 S, Rge. 6 W
(Smallest legal subdivision) (N. or S.) (E. or W.)

or (b) within limits of recorded-platted property, town or city:

in Lot _____, Block _____ of _____
(Name of plat or addition)County of _____
(If within city or town, give name)3. Construction Work was begun on May, 1954; was completed on July, 1955
(Date) (Date)and the ground water claimed was first used for the purposes set out below on July, 1955
(Date)since which time the water has been used continuously for domestic purposes plus 1 acre irrigated.
(Continuously or Intermittently)from July, 1955 to present
(Date) (Date)4. Quantity of water claimed and used is 35 gallons per minute; 30 acre feet per year.5. Purpose or Purposes for which water is used domestic and irrigation

(Domestic, irrigation, municipal, manufacturing, industrial, etc.)

6. Description of Well: Depth 60 feet. Type drilled
(Dug or drilled)diameter 6" inches. Elevation of ground at well site 400 feet, mean sea level.
(As near as known)Depth to water table 6 feet.7. Capacity of Well: 35 g.p.m. with 6 feet drawdown.

g.p.m. with _____ feet drawdown.

Date of test July, 1955If Flowing Well: Measured discharge _____ g.p.m. on _____
(Date)Shut-in pressure at ground surface _____ lbs. per sq. in. on _____
(Date)Water is controlled by _____
(Cap, valve, etc.)

8. Casing: (Give diameter, commercial specifications and depth below ground surface of each casing size.)

6" inch diameter from 0 to 14 feet
 inch diameter from to feet
 inch diameter from to feet
 inch diameter from to feet

Describe and show depth of shoe, plug, adapter, liner or other details:


9. Perforated Casings or Screens:

..... from to
 (Number per foot and size of perforations, or describe screen)
 from to
 from to
 from to

10. Log of Well: (Describe each stratum or formation clearly, indicate if water bearing, and give thickness and depth as indicated.)

MATERIAL	Thickness (Feet)	Depth to Bottom (Feet)
yellow clay	2	2
blue clay	2	4
Grey clay	10	14
black shale	10	24
grey shale (water vein)	2	26
black shale	10	36
grey shale (water vein)	2	38
black shale	10	48
grey shale (water vein)	2	50
black shale	8	58
grey shale (water vein)	2	60

Township 13 S Range 6 W W.M.
North

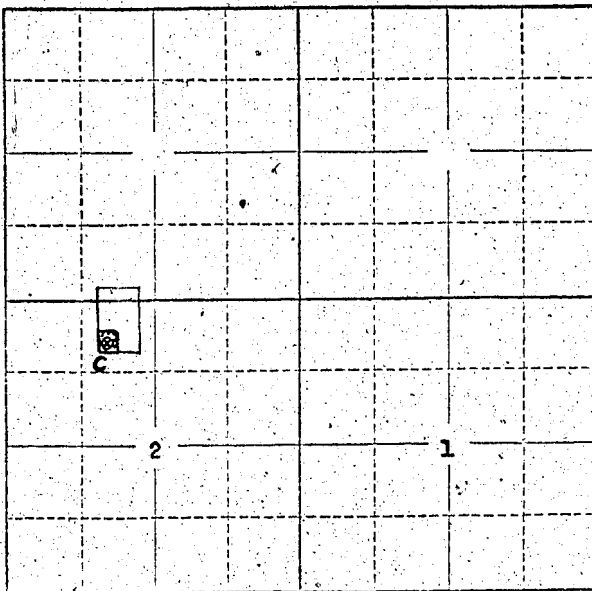

Locate well and acreage of irrigated land on plat.
Scale: 2" = 1 Mile

STATE OF OREGON

County of BENTON

} ss.

I, HERBERT PEARSON, being first duly sworn, do hereby certify that I have read the foregoing Registration Statement and that all of the items therein contained are true to the best of my knowledge and belief.

Herbert Pearson
(Signature of Registrant)

Subscribed and sworn to before me this 21 day of JUNE, 1958

My commission expires 11-24-61

Earl Barker
(Notary Public)

(SEAL)

CERTIFICATE OF REGISTRATION

STATE OF OREGON

County of Marion

} ss.

This is to certify that the foregoing Registration Statement was received in the office of the State Engineer on the 21st day of June, 1958, at 8:00 o'clock A.M. and has been duly recorded in said office in Book No. 16 of Registration Statements on page 61-3824

~~Construction shall be completed by _____ and the water completely applied to _____~~

Witness my hand this 4th day of December, 1959

Lewis A. Stanley
(State Engineer)

By _____ (Deputy)

\$15.00

6R-3824