

Registration Statement

OF CLAIMANT OF RIGHT TO APPROPRIATE GROUND WATER

TO THE STATE ENGINEER OF OREGON:

I, Earl K. and Cora E. Miller

of Rt. 1, Box 275, Albany

County of Linn

State of Oregon

do hereby make application for a certificate of registration as evidence of a right to appropriate ground water.

1. Source from which water is withdrawn is Pump well

(Flowing well, pump well, infiltration trench, or tunnel)

2. Location is: 6 miles East of Albany, Oregon

(Approximate distance and direction from nearest city or town)

and is more particularly described as follows:

(a) 2376' N. and 100' E. of SW corner of S. 5, T. 11 S, R. 2 W.

(Give distance and bearing to corner of section or other legal subdivision)

being within NW $\frac{1}{4}$ of SW $\frac{1}{4}$

(Smallest legal subdivision)

of Sec. 5

Twp. 11 S

(N. or S.)

Rge. 2 W

(E. or W.)

or (b) within limits of recorded platted property, town or city:

in Lot _____, Block _____ of _____

(Name of plat or addition)

County of Linn

(If within city or town, give name)

3. Construction Work was begun on May 1946

(Date)

; was completed on May 1946

(Date)

and the ground water claimed was first used for the purposes set out below on May 1946

(Date)

since which time the water has been used continuously

(Continuously or intermittently)

from May 1946 to present time

(Date)

(Date)

4. Quantity of water claimed and used is 60 gallons per minute; 52.0 acre feet per year.

5. Purpose or Purposes for which water is used Irrigation

(Domestic, irrigation, municipal, manufacturing, industrial, etc.)

6. Description of Well: Depth 70 feet. Type Drilled

(Dug or drilled)

diameter 8 inches. Elevation of ground at well site 230 feet, mean sea level.

(As near as known)

Depth to water table 21 feet.

7. Capacity of Well: _____ g.p.m. with _____ feet drawdown.

_____ g.p.m. with _____ feet drawdown.

Date of test Not Tested

If Flowing Well: Measured discharge _____ g.p.m. on _____

(Date)


Shut-in pressure at ground surface _____ lbs. per sq. in. on _____

(Date)

Water is controlled by _____

(Cap, valve, etc.)

Township 11 S Range 2 W W.M.
North

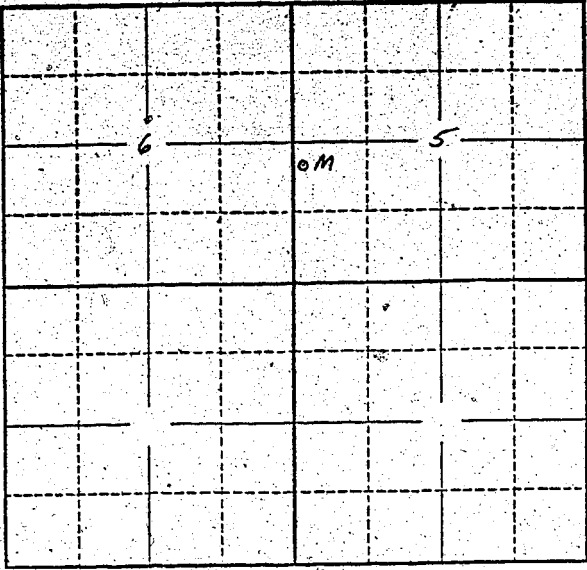

Locate well and acreage of irrigated land on plat.
Scale: 2" = 1 Mile

STATE OF OREGON
County of LINN

ss.

I, Earl K. and Cora E. Miller, being first duly sworn, do hereby certify that I have read the foregoing Registration Statement and that all of the items therein contained are true to the best of my knowledge and belief.

Earl K. Miller
Cora E. Miller
(Signature of Registrant)

Subscribed and sworn to before me this 23rd day of June, 1959

My commission expires 2/19/59 Harold Carpenter
(Notary Public)

(SEAL)

CERTIFICATE OF REGISTRATION

STATE OF OREGON
County of Marion

ss.

This is to certify that the foregoing Registration Statement was received in the office of the State Engineer on the 24th day of June, 1959, at 8:00 o'clock A. M. and has been duly recorded in said office in Book No. 8 of Registration Statements on page GR-1723

Witness my hand this 7th day of January, 1959

Stuart A. Stanley
(State Engineer)

By _____
(Deputy)

\$15.00

GR-1723