

# Registration Statement

## OF CLAIMANT OF RIGHT TO APPROPRIATE GROUND WATER

TO THE STATE ENGINEER OF OREGON:

I, W. T. Parsons  
 of Williams County of Josephine  
 State of Oregon, do hereby make application for a certificate of registration as evidence  
 of a right to appropriate ground water.

1. Source from which water is withdrawn is Sump  
(Flowing well, pump well, infiltration trench, or tunnel)
2. Location is: 1/2 mile North of Williams, Oregon  
(Approximate distance and direction from nearest city or town)

and is more particularly described as follows:

(a) 1530 feet East & 309 feet North of the Swedner Sec. 26  
(Give distance and bearing to corner of section or other legal subdivision)  
 being within SE<sup>4</sup>SW<sup>4</sup> of Sec. 26, Twp. 38-S, Rge. 5-W  
(Smallest legal subdivision) (N. or S.) (E. or W.)

or (b) within limits of recorded platted property, town or city:  
 in Lot \_\_\_\_\_, Block \_\_\_\_\_ of \_\_\_\_\_  
(Name of plat or addition)  
 County of \_\_\_\_\_  
(If within city or town, give name)

3. Construction Work was begun on Oct 1948; was completed on Nov 1948  
(Date) (Date)  
 and the ground water claimed was first used for the purposes set out below on May 1949  
(Date)  
 since which time the water has been used Continuously during irrigation season  
(Continuously or intermittently)  
 from May 1949 to June 1958 (To date)  
(Date) (Date)

4. Quantity of water claimed and used is 250 gallons per minute; \_\_\_\_\_ acre  
 feet per year.

5. Purpose or Purposes for which water is used Irrigation  
(Domestic, irrigation, municipal, manufacturing, industrial, etc.)

6. Description of Well: Sump Depth \_\_\_\_\_ feet. Type \_\_\_\_\_  
(Dug or drilled)  
 diameter \_\_\_\_\_ inches. Elevation of ground at well site \_\_\_\_\_ feet, mean sea level.  
(AS near as known)  
 Depth to water table \_\_\_\_\_ feet.

7. Capacity of Well: \_\_\_\_\_ g.p.m. with \_\_\_\_\_ feet drawdown.  
 \_\_\_\_\_ g.p.m. with \_\_\_\_\_ feet drawdown.

Date of test \_\_\_\_\_

If Flowing Well: Measured discharge \_\_\_\_\_ g.p.m. on \_\_\_\_\_  
(Date)


Shut-in pressure at ground surface \_\_\_\_\_ lbs. per sq. in. on \_\_\_\_\_  
(Date)

Water is controlled by \_\_\_\_\_  
(Cap, valve, etc.)





Township 38 S Range 5 W, W.M.  
North

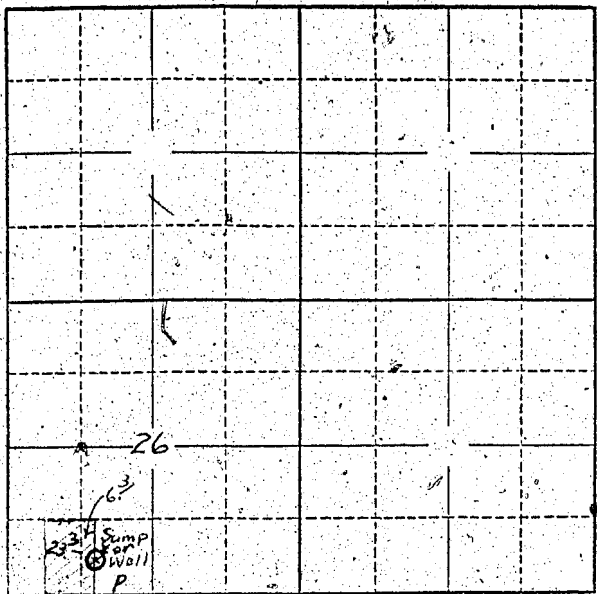

Locate well and acreage of irrigated land on plat.  
Scale: 2" = 1 Mile

STATE OF OREGON }  
County of Josephine } ss.

I, \_\_\_\_\_, being first duly sworn, do hereby certify that I have read the foregoing Registration Statement and that all of the items therein contained are true to the best of my knowledge and belief.

W. J. Parsons W. J. Parsons  
(Signature of Registrant)

Subscribed and sworn to before me this 14 day of July, 1959

My commission expires May 19, 1962 W. M. Taddler  
(Notary Public) for Oregon

(SEAL)

**CERTIFICATE OF REGISTRATION**

STATE OF OREGON }  
County of Marion } ss.

This is to certify that the foregoing Registration Statement was received in the office of the State Engineer on the 24<sup>th</sup> day of June, 1958, at 8:00 o'clock A. M. and has been duly recorded in said office in Book No. 16 of Registration Statements on page GR 3866

Witness my hand this 28<sup>th</sup> day of December, 1959

Lewis A. Stanley  
(State Engineer)

\$15.00

By \_\_\_\_\_ (Deputy)

GR 3866