

Registration Statement

OF CLAIMANT OF RIGHT TO APPROPRIATE GROUND WATER

TO THE STATE ENGINEER OF OREGON:

We Lee H. & Mariow B. Thompson
of Rt. 2 Box 1089, Sherwood County of Washington
(Mailing address)

State of Oregon, do hereby make application for a certificate of registration as evidence of a right to appropriate ground water.

- 1. Source from which water is withdrawn is deep well
(Dug well, pump well, infiltration trench, or tunnel)
- 2. Location is: 3 mi. So. of Tualatin on Mulloy Rd.
(Approximate distance and direction from nearest city or town)

and is more particularly described as follows:

(a) 465' E x 90' S of N.W. corner
(Give distance and bearing to corner of section or other legal subdivision)
being within NW 1/4 NW 1/4 of Sec. 2, Twp. 3 S, Rge. 1 W
(Smallest legal subdivision) (N. or S.) (E. or W.)

or (b) within limits of recorded platted property, town or city: _____

in Lot _____, Block _____ of _____
(Name of plat or addition)

County of _____
(If within city or town, give name)

3. Construction Work was begun on Oct. 1950; was completed on April 1954
(Date) (Date)

and the ground water claimed was first used for the purposes set out below on June 1951
(Date)

since which time the water has been used continuously
(Continuously or intermittently)

from April 1954 to June 24, 1958
(Date) (Date)

4. Quantity of water claimed and used is 55 gallons per minute; _____ acre feet per year.

5. Purpose or Purposes for which water is used Irrigation
(Domestic, irrigation, municipal, manufacturing, industrial, etc.)

6. Description of Well: Depth 247 feet. Type drilled
(Dug or drilled)

diameter 6 inches. Elevation of ground at well site 240 feet, mean sea level.
(As near as known)

Depth to water table 60 feet.

7. Capacity of Well: no test g.p.m. with _____ feet drawdown.
_____ g.p.m. with _____ feet drawdown.

Date of test _____


If Flowing Well: Measured discharge _____ g.p.m. on _____
(Date)

Shut-in pressure at ground surface _____ lbs. per sq. in. on _____
(Date)

Water is controlled by _____
(Cap. valve, etc.)

Township 35 Range 1W W.M.

North

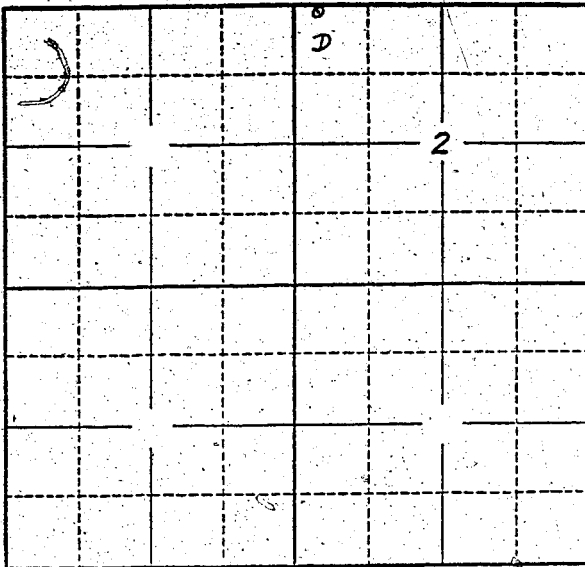

Locate well and acreage of irrigated land on plat.

Scale: 2" = 1 Mile

STATE OF OREGON

County of Marion

Lee H. Thompson

} ss.

I, Marion B. Thompson, being first duly sworn, do hereby certify that I have read the foregoing Registration Statement and that all of the items therein contained are true to the best of my knowledge and belief.

Marion B. Thompson
(Signature of Registrant)

Subscribed and sworn to before me this 24th day of June, 1958.

My commission expires Sept. 8, 1960

Charles H. [Signature]
(Notary Public)

(SEAL)

CERTIFICATE OF REGISTRATION

STATE OF OREGON

County of Marion

} ss.

This is to certify that the foregoing Registration Statement was received in the office of the State Engineer on the 24th day of June, 1958, at 9:30 o'clock A. M. and has been duly recorded in said office in Book No. 8 of Registration Statements on page GR-1725

Witness my hand this 7th day of January

1959
Lewis A. Stanley
(State Engineer)

\$15.00

By

(Deputy)

GR-1725