

Registration Statement

OF CLAIMANT OF RIGHT TO APPROPRIATE GROUND WATER

TO THE STATE ENGINEER OF OREGON:

I, W. L. Ferschweiler
 of Rt 1 Box 249 Gervais, Oregon County of MARION
 (Mailing address)
 State of OREGON, do hereby make application for a certificate of registration as evidence
 of a right to appropriate ground water.

1. Source from which water is withdrawn is Pumped Well
 (Flowing well, pump well, infiltration trench, or tunnel)

2. Location is: 3 miles west of Gervais
 (Approximate distance and direction from nearest city or town)

and is more particularly described as follows:

(a) 1600' N & 3100' E from SW corner DLC #42, A F Polanquin
 (Give distance and bearing to corner of section or other legal subdivision)
 being within NE 1/4 SW 1/4 of Sec. 21, Twp. 5S, Rge. 2W
 (Smallest legal subdivision) (N. or S.) (E. or W.)

or (b) within limits of recorded platted property, town or city:

in Lot _____, Block _____ of _____
 (Name of plat or addition)

County of _____
 (If within city or town, give name)

3. Construction Work was begun on AUG 1951; was completed on AUG 1951
 (Date) (Date)
 and the ground water claimed was first used for the purposes set out below on MAY 1952
 (Date)

since which time the water has been used INTERMITTENTLY
 (Continuously or intermittently)
 from APRIL to SEP OCTOBER
 (Date) (Date)

4. Quantity of water claimed and used is 120 gallons per minute; 150 acre
 feet per year.

5. Purpose or Purposes for which water is used DOMESTIC + IRRIGATION

(Domestic, irrigation, municipal, manufacturing, industrial, etc.)

6. Description of Well: Depth 134 feet. Type DRILLED
 (Dug or drilled)
 diameter 7 inches. Elevation of ground at well site 180' feet, mean sea level.
 (As near as known)

Depth to water table 12 feet.

7. Capacity of Well: 160 g.p.m. with 33 feet drawdown.
175 g.p.m. with 41 feet drawdown.

Date of test 12-11-51

If Flowing Well: Measured discharge _____ g.p.m. on _____
 (Date)

Shut-in pressure at ground surface _____ lbs. per sq. in. on _____
 (Date)

Water is controlled by _____
 (Cap, valve, etc.)

4" O.D. inch diameter	from TOP	to 131	feet
inch diameter	from	to	feet
inch diameter	from	to	feet
inch diameter	from	to	feet

9. Perforated Casings or Screens:

Not Perforated

(Number per foot and size of perforations, or distance between)

from _____ to _____
from _____ to _____
from _____ to _____
from _____ to _____

[illegible]

If log of well is not available, give name and address of driller. _____

X. Infiltration Trench: Covered or open -----

Dimensions: Length _____ ft. Minimum depth _____ ft. Maximum depth _____ ft.

Bottom width _____ ft. Discharge _____ g.p.m. Date of test _____

~~X~~ Tunnel: Type of lining

Dimensions: _____ (Length, course, and cross sectional size)

Position of water bearing stratum with reference to portal of tunnel

Log of tunnel: (Preceding table for log of well may be used, if desired. Give footage from portal and character of materials, as pertinent.)

13. Pumping Equipment:

(a) Pump Peerless Turbine Capacity 175 g.p.m.
(Make, type and size)

(b) Motor 10 H.P.
(Type and horsepower)


14. Location of area irrigated or to be irrigated, or place of use if for purposes other than irrigation.

[illegible]

15. If the ground water supply is supplemental to an existing water supply, identification of any application for a permit, permit, certificate or adjudicated right to appropriate water made or held by the registrant.

None

Sec 21 Township 55 Range R2 W, W.M.
North

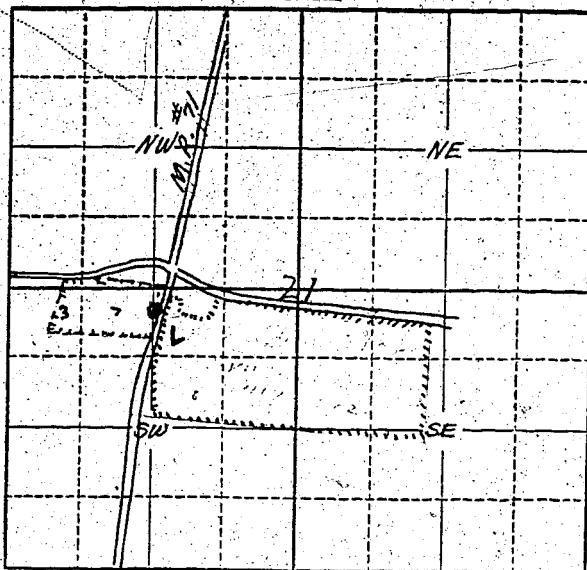

Locate well and acreage of irrigated land on plat.

Scale: 1" = 1 Mile

STATE OF OREGON

County of Marion

ss.

I, Lloyd L. Fenschweiler, being first duly sworn, do hereby certify that I have read the foregoing Registration Statement and that all of the items therein contained are true to the best of my knowledge and belief.

Lloyd L. Fenschweiler
(Signature of Registrant)

Subscribed and sworn to before me this 24th day of June, 1958.

My commission expires Sept. 8, 1960.

Chas. F. Stanley
(Notary Public)

(SEAL)

CERTIFICATE OF REGISTRATION

STATE OF OREGON

County of Marion

ss.

This is to certify that the foregoing Registration Statement was received in the office of the State Engineer on the 24th day of June, 1958, at 9:45 o'clock A.M. and has been duly recorded in said office in Book No. 8 of Registration Statements on page GR-1726

Witness my hand this 7th day of January

1959

Leura A. Stanley
(State Engineer)

By

(Deputy)

\$21.00

GR-1726