

Registration Statement

OF CLAIMANT OF RIGHT TO APPROPRIATE GROUND WATER

TO THE STATE ENGINEER OF OREGON:

I, VIRGIL W. NELSON

of Rt. 1, Box 237, Eagle Creek County of CLACKAMAS

State of OREGON, do hereby make application for a certificate of registration as evidence of a right to appropriate ground water.

- 1. Source from which water is withdrawn is PUMP WELL
(Flowing well, pump well, infiltration trench, or tunnel)
- 2. Location is: 1/4 MILE N.E. OF EAGLE CREEK
(Approximate distance and direction from nearest city or town)

and is more particularly described as follows:

(a) N 18° W, 1965 FEET FROM S.E. CORNER OF SECTION 29
(Give distance and bearing to corner of section or other legal subdivision)
being within NE 1/4 SE 1/4 of Sec. 29, Twp. 2S, Rge. 4E
(Smallest legal subdivision) (N. or S.) (E. or W.)

or (b) within limits of recorded platted property, town or city:

in Lot _____, Block _____ of _____
(Name of plat or addition)
County of _____
(If within city or town, give name)

3. Construction Work was begun on Dec-27-1952; was completed on Jan-8-1953
(Date) (Date)

and the ground water claimed was first used for the purposes set out below on April-1953
(Date)
since which time the water has been used Continuously &
(Continuously or intermittently)
from April to OCTOBER
(Date) (Date)

4. Quantity of water claimed and used is 60 gallons per minute; _____ acre feet per year.

5. Purpose or Purposes for which water is used IRRIGATION

(Domestic, irrigation, municipal, manufacturing, industrial, etc.)

6. Description of Well: Depth 176 feet. Type DRILLED
(Dug or drilled)

diameter 6 inches. Elevation of ground at well site 710 feet, mean sea level.
(As near as known)

Depth to water table 6.7 feet.

7. Capacity of Well: 70 g.p.m. with 5'8" feet drawdown.
60 g.p.m. with 3'8" feet drawdown.


Date of test JAN 6 1953

If Flowing Well: Measured discharge _____ g.p.m. on _____
(Date)

Shut-in pressure at ground surface _____ lbs. per sq. in. on _____
(Date)

Water is controlled by _____
(Cap, valve, etc.)

Township 25 Range 4E, W.M.
North

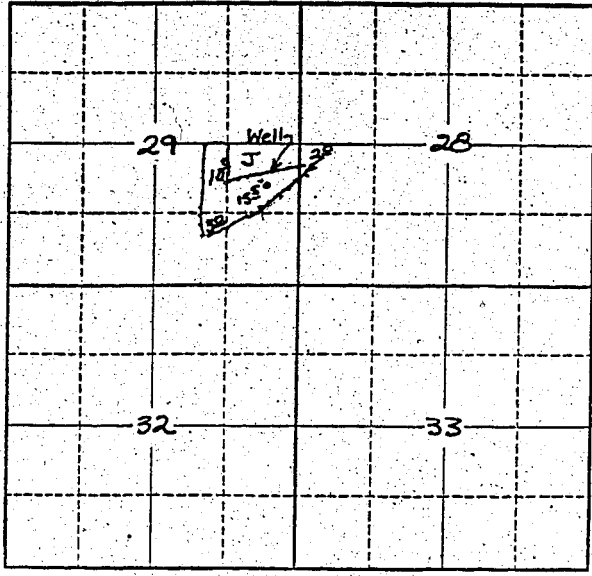

Locate well and acreage of irrigated land on plat.
Scale: 2" = 1 Mile

STATE OF OREGON

County of Tillamook } ss.

I, Cornell Nelson, being first duly sworn, do hereby certify that I have read the foregoing Registration Statement and that all of the items therein contained are true to the best of my knowledge and belief.

Cornell Nelson
(Signature of Registrant)

Subscribed and sworn to before me this 24 day of January, 1953

NOTARY PUBLIC FOR OREGON

My commission expires MY COMMISSION EXPIRES SEPT 25, 1960

George W. McKinney
(Notary Public)

(SEAL)

CERTIFICATE OF REGISTRATION

STATE OF OREGON

County of Marion } ss.

This is to certify that the foregoing Registration Statement was received in the office of the State Engineer on the 25th day of June, 1952, at 8:00 o'clock A. M. and has been duly recorded in said office in Book No. 8 of Registration Statements on page GR-1735

Witness my hand this 7th day of January, 1959

Henry A. Stanley
(State Engineer)

By _____
(Deputy)

\$15.15

GR-1735