

Well No. 1

REGISTRATION NO. GR-1799

Registration Statement CERTIFICATE NO. GR-1740

OF CLAIMANT OF RIGHT TO APPROPRIATE GROUND WATER

(Under Chapter 708, Oregon Laws 1955.)

TO THE STATE ENGINEER OF OREGON:

I, MALCOLM W. EDMUNSON

of Route 2, Springfield County of Lane

State of Oregon, do hereby make application for a certificate of registration as evidence of a right to appropriate ground water.

1. Source from which water is withdrawn is Pump well #1
(Flowing well, pump well, infiltration trench, or tunnel)

2. Location is: Five miles north east of Springfield
(Approximate distance and direction from nearest city or town)

and is more particularly described as follows:

(a) 580 feet south and 250 feet west of the ^{N 1/4 corner} center of sections ~~28~~ and 29
(Give distance and bearing to corner of section or other legal subdivision)

being within NE 1/4 of NW 1/4 of Sec. 29, Twp. 17S, Rge. 2W
(Smallest legal subdivision) (N. or S.) (E. or W.)

or (b) within limits of recorded platted property, town or city:

in Lot _____, Block _____ of _____
(Name of plat or addition)

County of _____
(If within city or town, give name)

3. Construction Work was begun on 1948; was completed on 1948
(Date) (Date)

and the ground water claimed was first used for the purposes set out below on 1948
(Date)

since which time the water has been used Continuously
(Continuously or Intermittently)

from 1948 to 1958
(Date) (Date)

4. Quantity of water claimed and used is 160 gallons per minute; 8 acre feet per year.

5. Purpose or Purposes for which water is used Irrigation
(Domestic, irrigation, municipal, manufacturing, industrial, etc.)

6. Description of Well: Depth 20 feet. Type Drilled
(Dug or drilled)

diameter 4 inches. Elevation of ground at well site 470 feet, mean sea level
(As near as known)

Depth to water table 10 feet.

7. Capacity of Well: 200 g.p.m. with nil feet drawdown.

_____ g.p.m. with _____ feet drawdown.


Date of test: _____

If Flowing Well: Measured discharge _____ g.p.m. on _____
(Date)

Shut-in pressure at ground surface _____ lbs. per sq. in. on _____
(Date)

Water is controlled by _____
(Cap, valve, etc.)

Township 17S Range 2W, W.M.
North

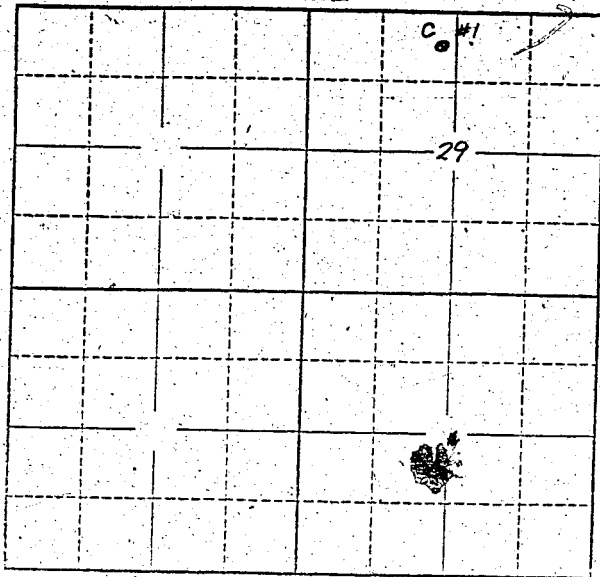

Locate well and acreage of irrigated land on plat.
Scale: 2" = 1 Mile

STATE OF OREGON

County of Leura } ss.

I, M. W. Edman, being first duly sworn, do hereby certify that I have read the foregoing Registration Statement and that all of the items therein contained are true to the best of my knowledge and belief.

M. W. Edman
(Signature of Registrant)

Subscribed and sworn to before me this 6 day of June, 1958.

My commission expires NOTARY PUBLIC FOR OREGON
(SEAL) My Commission Expires Feb. 7, 1960

[Signature]
(Notary Public)

CERTIFICATE OF REGISTRATION

STATE OF OREGON

County of Marion } ss.

This is to certify that the foregoing Registration Statement was received in the office of the State Engineer on the 25th day of June, 1958, at 5.00 o'clock A. M. and has been duly recorded in said office in Book No. 8 of Registration Statements on page GR-1740

~~Construction shall be completed by _____ and the water conserved and applied to beneficial use by _____~~

Witness my hand this 7th day of January, 1959

Lewis A. Stanley
(State Engineer)

\$1.50

By _____ (Deputy)

GR-1740