

Registration Statement

OF CLAIMANT OF RIGHT TO APPROPRIATE GROUND WATER

(Under Chapter 708, Oregon Laws 1955.)

TO THE STATE ENGINEER OF OREGON:

I, Henry Letterman PT # Box 250
of Ascola Oregon County of Marion

State of Oregon do hereby make application for a certificate of registration as evidence of a right to appropriate ground water.

1. Source from which water is withdrawn is Flowing well
(Flowing well, pump well, infiltration trench, or tunnel)

2. Location is: 2 1/2 miles S. W. of Ascola
(Approximate distance and direction from nearest city or town)

and is more particularly described as follows:

(a) Starting at the S.W. corner of Sec. 15 East 120 Ads. thence 270ft. N.
(Give distance and bearing to corner of section or other legal subdivision)

being within SE 1/4 of SW 1/4 of Sec. 15, Twp. 4S, Rge. 1W
(Smallest legal subdivision) (N. or S.) (E. or W.)

or (b) within limits of recorded platted property, town or city:

in Lot _____, Block _____ of _____
(Name of plat or addition)

County of _____
(If within city or town, give name)

3. Construction Work was begun on Oct - 1951; was completed on Dec 18 - 1957
(Date) (Date)

and the ground water claimed was first used for the purposes set out below on June 1952
(Date)

since which time the water has been used Intermittently
(Continuously or Intermittently)

from June to Sept.
(Date) (Date)

4. Quantity of water claimed and used is 320 gallons per minute; to acre feet per year.

5. Purpose or Purposes for which water is used Irrigation

(Domestic, irrigation, municipal, manufacturing, industrial, etc.)

6. Description of Well: Depth 110 feet. Type Drilled
(Dug or drilled)

diameter 12 inches. Elevation of ground at well site 178 feet, mean sea level.
(As near as known)

Depth to water table 32 feet.

7. Capacity of Well: 320 g.p.m. with 8.3 feet drawdown below land surface

360 g.p.m. with 8.9 feet drawdown.

Date of test Dec 15 - 1951

If Flowing Well: Measured discharge _____ g.p.m. on _____
(Date)

Shut-in pressure at ground surface _____ lbs. per sq. in. on _____
(Date)

Water is controlled by _____
(Cap, valve, etc.)

8. **Casing:** (Give diameter, commercial specifications and depth below ground surface of each casing size.)

12 inch diameter Steel casing from 0 to 110 feet
 inch diameter from to feet
 inch diameter from to feet
 inch diameter from to feet

Describe and show depth of shoe, plug, adapter, liner or other details:

9. **Perforated Casings or Screens:**

Perforated 3/8 in from 98 to 105
(Number per foot and size of perforations, or describe screen)
 from to
 from to
 from to

10. **Log of Well:** (Describe each stratum or formation clearly, indicate if water bearing, and give thickness and depth as indicated.)

MATERIAL	Thickness (Feet)	Depth to Bottom (Feet)
<u>No record</u>		

If log of well is not available, give name and address of driller. *J. T. Miller*

11. Infiltration Trench: Covered or open

Dimensions: Length _____ ft. Minimum depth _____ ft. Maximum depth _____ ft.
Bottom width _____ ft. Discharge _____ g.p.m. Date of test _____

12. Tunnel: Type of lining _____

Dimensions: _____ (Length, course, and cross sectional size)
Position of water bearing stratum with reference to portal of tunnel _____

Log of tunnel: (Preceding table for log of well may be used, if desired. Give footage from portal and character of materials, as pertinent.)

13. Pumping Equipment:


(a) Pump _____ *Turbine* _____ Capacity *400* g.p.m.
(Type, type and size)
(b) Motor _____ *20 H.P.* _____
(Type and horsepower)

14. Location of area irrigated or to be irrigated, or place of use if for purposes other than irrigation.

Township North or South	Range E. or W. of Willamette Meridian	Section	Forty-acre Tract	Number Acres To Be Irrigated	Date of Reclamation
<i>4S</i>	<i>1W</i>	<i>15</i>	<i>SE 1/4 of SW 1/4</i>	<i>32</i>	<i>June 1952</i>
<i>4S</i>	<i>1W</i>	<i>15</i>	<i>SW 1/4 of SE 1/4</i>	<i>4</i>	<i>June 1952</i>
"	"	<i>15</i>	<i>NW 1/4 of SE 1/4</i>	<i>3</i>	<i>June 1952</i>
"	"	<i>15</i>	<i>NE 1/4 of SW 1/4</i>	<i>30</i>	<i>Oct 1, 1957</i>
"	"	<i>22</i>	<i>NW 1/4 of NW 1/4</i>	<i>8</i>	<i>Oct 1, 1957</i>
				<i>77</i>	

15. If the ground water supply is supplemental to an existing water supply, identification of any application for a permit, permit, certificate or adjudicated right to appropriate water made or held by the registrant.

Township 4 S Range 1 W W.M.
North

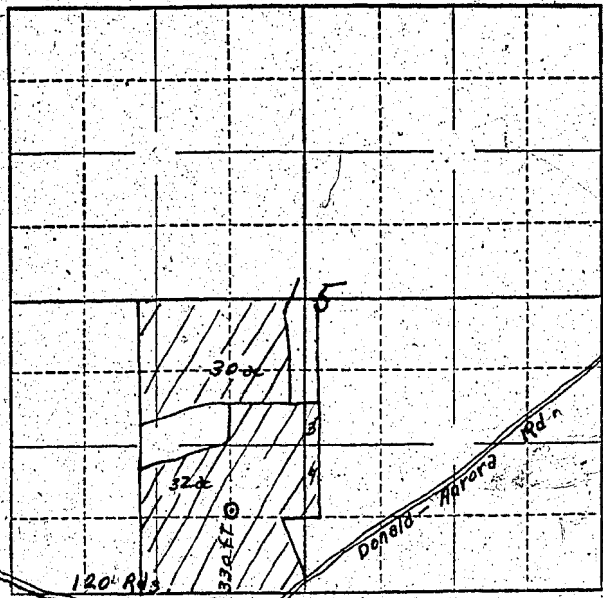

Locate well and acreage of irrigated land on plat.
Scale: 2" = 1 Mile

STATE OF OREGON }
County of } ss.

I, Henry Lettenmaier, being first duly sworn, do hereby certify that I have read the foregoing Registration Statement and that all of the items therein contained are true to the best of my knowledge and belief.

Henry Lettenmaier
(Signature of Registrant)

Subscribed and sworn to before me this 8th day of May, 1956.

My commission expires Jan 15, 1957.

Permy J. Boyd
(Notary Public)

(SEAL)

CERTIFICATE OF REGISTRATION

STATE OF OREGON }
County of Marion } ss.

This is to certify that the foregoing Registration Statement was received in the office of the State Engineer on the 10th day of May, 1956, at 8 o'clock A. M. and has been duly recorded in said office in Book No. 1 of Registration Statements on page GR-167 C.
Construction ~~shall be~~ completed by ~~October 1, 1956~~ and the water ~~shall be~~ completely applied to beneficial use by October 1, 1958.

Witness my hand this 8th day of October, 1956.

Lewis A. Stanley
(State Engineer)

By
(Deputy)

GR-167C