

# Registration Statement CERTIFICATE NO. GR-1742

## OF CLAIMANT OF RIGHT TO APPROPRIATE GROUND WATER

(Under Chapter 708, Oregon Laws 1955.)

TO THE STATE ENGINEER OF OREGON:

I, HORACE H. MIEES

of Route 2, Springfield County of Lane

State of Oregon, do hereby make application for a certificate of registration as evidence of a right to appropriate ground water.

1. Source from which water is withdrawn is Pump well  
(Flowing well, pump well, infiltration trench, or tunnel)

2. Location is: Five miles northeast of Springfield, Oregon  
(Approximate distance and direction from nearest city or town)

and is more particularly described as follows:

(a) 1670 feet south and 120 feet east of the <sup>N 1/4</sup> corner center of Sections 28 and 29  
(Give distance and bearing to corner of section or other legal subdivision)

being within SW 1/4 of NE 1/4 of Sec. 29, Twp. 17S, Rge. 2W  
(Smallest legal subdivision) (N. or S.) (E. or W.)

or (b) within limits of recorded platted property, town or city:

in Lot \_\_\_\_\_, Block \_\_\_\_\_ of \_\_\_\_\_  
(Name of plat or addition)

County of \_\_\_\_\_  
(If within city or town, give name)

3. Construction Work was begun on 1940; was completed on 1940  
(Date) (Date)

and the ground water claimed was first used for the purposes set out below on 1940  
(Date)

since which time the water has been used Irrigation -- continuously  
(Continuously or intermittently)

from 1940 to Oct. 1958  
(Date) (Date)

4. Quantity of water claimed and used is 125 gallons per minute; 10 20 acre feet per year.

5. Purpose or Purposes for which water is used Irrigation

(Domestic, irrigation, municipal, manufacturing, industrial, etc.)

6. Description of Well: Depth 20 feet. Type Drilled  
(Dug or drilled)

diameter 3 inches. Elevation of ground at well site 476 feet, mean sea level.  
(As near as known)

Depth to water table 12 feet.

7. Capacity of Well: 150 g.p.m. with nil feet drawdown.

\_\_\_\_\_ g.p.m. with \_\_\_\_\_ feet drawdown.

Date of test \_\_\_\_\_

If Flowing Well: Measured discharge \_\_\_\_\_ g.p.m. on \_\_\_\_\_  
(Date)


Shut-in pressure at ground surface \_\_\_\_\_ lbs. per sq. in. on \_\_\_\_\_  
(Date)

Water is controlled by \_\_\_\_\_  
(Cap, valve, etc.)





Township 175 Range 2W W.M.  
North

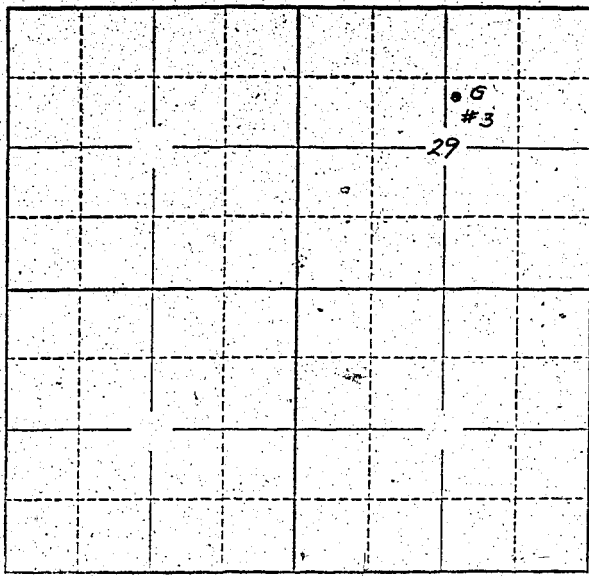

Locate well and acreage of irrigated land on plat.  
Scale: 2" = 1 Mile

STATE OF OREGON

County of Lane ss.

Howard Myers, being first duly sworn, do hereby certify that I have read the foregoing Registration Statement and that all of the items therein contained are true to the best of my knowledge and belief.

Howard Myers  
(Signature of Registrant)

Subscribed and sworn to before me this 21<sup>st</sup> day of June, 1958.

My commission expires \_\_\_\_\_  
W. J. [Signature]  
(Notary Public)

(SEAL)

**CERTIFICATE OF REGISTRATION**

STATE OF OREGON

County of Marion } ss.

This is to certify that the foregoing Registration Statement was received in the office of the State Engineer on the 25<sup>th</sup> day of June, 1958, at 8:00 o'clock A.M. and has been duly recorded in said office in Book No. 8 of Registration Statements on page GR 1742.

~~Construction shall be completed by \_\_\_\_\_ and the water completely applied to beneficial use by \_\_\_\_\_.~~

Witness my hand this 7<sup>th</sup> day of January, 1959.  
Levin A. Stanley  
(State Engineer)

#15.00

By \_\_\_\_\_  
(Deputy)

GR 1742