

Registration Statement CERTIFICATE NO. GR-1743

OF CLAIMANT OF RIGHT TO APPROPRIATE GROUND WATER

(Under Chapter 708, Oregon Laws 1955.)

TO THE STATE ENGINEER OF OREGON:

F.

PHIL HENRY

I, _____
of Route 2, Springfield County of Lane

State of Oregon, do hereby make application for a certificate of registration as evidence of a right to appropriate ground water.

1. Source from which water is withdrawn is Pump well #4
(Flowing well, pump well, infiltration trench, or tunnel)

2. Location is: Five miles northeast of Springfield, Oregon
(Approximate distance and direction from nearest city or town)

and is more particularly described as follows:

(a) 1720 feet south and 100 feet east of the ^{N 1/4 corner} center of Sections ~~28~~ and 29
(Give distance and bearing to corner of section or other legal subdivision)

being within SW 1/4 of NE 1/4 of Sec. 29, Twp. 17S, Rge. 2W
(Smallest legal subdivision) (N. or S.) (E. or W.)

or (b) within limits of recorded platted property, town or city: _____

in Lot _____ Block _____ of _____
(Name of plat or addition)

County of _____
(If within city or town, give name)

3. Construction Work was begun on Original well, 1926 Renewed 1953; was completed on Original well, 1926 Renewed 1953
(Date) (Date) (Date) (Date)

and the ground water claimed was first used for the purposes set out below on 1926
(Date)

since which time the water has been used Continuously
(Continuously or intermittently)

from 1926 to Oct. 1958
(Date) (Date)

4. Quantity of water claimed and used is 125 gallons per minute; 12 acre feet per year.

5. Purpose or Purposes for which water is used Irrigation

(Domestic, irrigation, municipal, manufacturing, industrial, etc.)

6. Description of Well: Depth 20 feet. Type Drilled
(Dug or drilled)

diameter 4 inches. Elevation of ground at well site 476 feet, mean sea level.
(As near as known)

Depth to water table 12 feet.

7. Capacity of Well: 200 g.p.m. with nil feet drawdown.

_____ g.p.m. with _____ feet drawdown.

Date of test _____

If Flowing Well: Measured discharge _____ g.p.m. on _____
(Date)

Shut-in pressure at ground surface _____ lbs. per sq. in. on _____
(Date)

Water is controlled by _____
(Cap. valve, etc.)

8. Casing: (Give diameter, commercial specifications and depth below ground surface of each casing size.)

4 inch diameter Standard black iron pipe from 0 to 20 feet
 inch diameter from to feet
 inch diameter from to feet
 inch diameter from to feet

Describe and show depth of shoe, plug, adapter, liner or other details: None

9. Perforated Casings or Screens:

Perforated from to
 (Number per foot and size of perforations, or describe screen)
 from to
 from to
 from to

10. Log of Well: (Describe each stratum or formation clearly, indicate if water bearing, and give thickness and depth as indicated.)

MATERIAL	Thickness (Feet)	Depth to Bottom (Feet)
Chehalis sandy clay loam	6	14
River gravel	14	0

If log of well is not available, give name and address of driller.

11. Infiltration Trench: Covered or open

Dimensions: Length ft. Minimum depth ft. Maximum depth ft.

Bottom width ft. Discharge g.p.m. Date of test

12. Tunnel: Type of lining

Dimensions:
(Length, course, and cross sectional size)

Position of water bearing stratum with reference to portal of tunnel

Log of tunnel: (Preceding table for log of well may be used, if desired. Give footage from portal and character of materials, as pertinent.)

13. Pumping Equipment:

(a) Pump Fairbanks-Morse centrifugal ^{1 1/2}" discharge
(Make, type and size) ²" intake, Capacity 125 g.p.m.

(b) Motor Electric 5 hp.
(Type and horsepower)


14. Location of area irrigated or to be irrigated, or place of use if for purposes other than irrigation.

Township North or South	Range E. or W. of Willamette Meridian	Section	Forty-acre Tract	Number Acres To Be Irrigated	Date of Reclamation
17S	2WWM	29SW ¹	of NE ¹	8.0	1926

15. If the ground water supply is supplemental to an existing water supply, identification of any application for a permit, permit, certificate or adjudicated right to appropriate water made or held by the registrant.

No

Township 17S Range 2W, W.M.
North

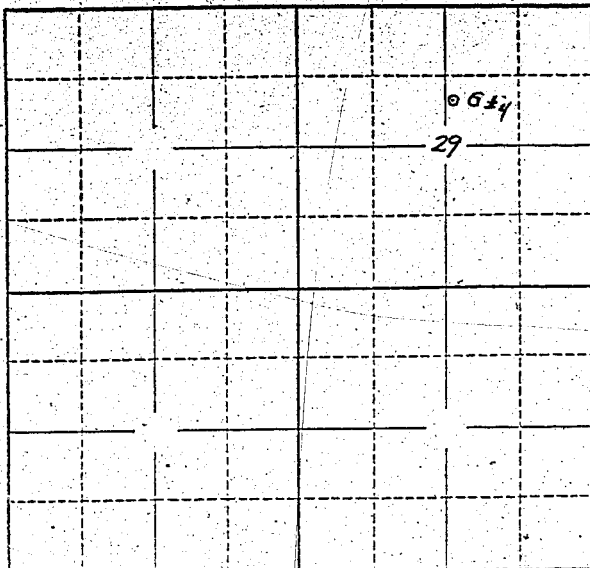

Locate well and acreage of irrigated land on plat.
Scale: 2" = 1 Mile

STATE OF OREGON

County of Lane } ss.

I, Phil F. Henry, being first duly sworn, do hereby certify that I have read the foregoing Registration Statement and that all of the items therein contained are true to the best of my knowledge and belief.

Phil F. Henry
(Signature of Registrant)

Subscribed and sworn to before me this 21st day of May, 1958

Commission Expires February 1, 1961

My commission expires _____
(Notary Public)

(SEAL)

CERTIFICATE OF REGISTRATION

STATE OF OREGON } ss.
County of Marion

This is to certify that the foregoing Registration Statement was received in the office of the State Engineer on the 25th day of June, 1958, at 8:00 o'clock A.M. and has been duly recorded in said office in Book No. 8 of Registration Statements on page GR-1743

~~Construction shall be completed by _____ and the water completely applied for beneficial use by _____~~

Witness my hand this 7th day of January, 1959.

Lewis A. Stanley
(State Engineer)

\$ 15.00

By _____ (Deputy)

GR-1743