

We 77 No. 6

REGISTRATION NO. GR-1824

Registration Statement CERTIFICATE NO. GR-1745

OF CLAIMANT OF RIGHT TO APPROPRIATE GROUND WATER

(Under Chapter 708, Oregon Laws 1955.)

TO THE STATE ENGINEER OF OREGON:

I, HORACE H. MYERS

of Route 2, Springfield County of Lane

State of Oregon, do hereby make application for a certificate of registration as evidence of a right to appropriate ground water.

1. Source from which water is withdrawn is Pump well #6
(Flowing well, pump well, infiltration trench, or tunnel)

2. Location is: Five miles northeast of Springfield, Oregon
(Approximate distance and direction from nearest city or town)

and is more particularly described as follows:

(a) 1930 feet south and 1530 west of the ^{N 1/4 corner} ~~corner~~ of Sections ~~28~~ ~~29~~ 29
(Give distance and bearing to corner of section or other legal subdivision)

being within SW 1/4 of NW 1/4 of Sec. 29, Twp. 17S, Rge. 2WMM
(Smallest legal subdivision) (N. or S.) (E. or W.)

or (b) within limits of recorded platted property, town or city:

in Lot _____, Block _____ of _____
(Name of plat or addition)

County of _____
(If within city or town, give name)

3. Construction Work was begun on 1935; was completed on 1935
(Date) (Date)

and the ground water claimed was first used for the purposes set out below on 1935
(Date)

since which time the water has been used Continuously
(Continuously or Intermittently)

from 1935 to 1958
(Date) (Date)

4. Quantity of water claimed and used is 175 gallons per minute; 35 acre feet per year.

5. Purpose or Purposes for which water is used Irrigation

(Domestic, irrigation, municipal, manufacturing, industrial, etc.)

6. Description of Well: Depth 14 feet. Type Dug
(Dug or drilled)

diameter 28 inches. Elevation of ground at well site 476 feet, mean sea level.
(As near as known)

Depth to water table 10 feet.

7. Capacity of Well: 300 g.p.m. with nil feet drawdown.

_____ g.p.m. with _____ feet drawdown.


Date of test _____

If Flowing Well: Measured discharge _____ g.p.m. on _____
(Date)

Shut-in pressure at ground surface _____ lbs. per sq. in. on _____
(Date)

Water is controlled by _____
(Cap, valve, etc.)

Township 17S Range 2W W.M.
North

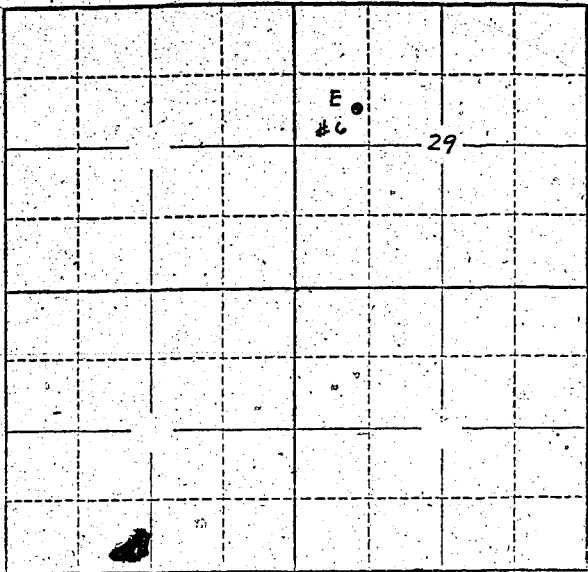

Locate well and acreage of irrigated land on plat.
Scale: 2" = 1 Mile

STATE OF OREGON

County of Lane } ss.

Harold H. Myers, being first duly sworn, do hereby certify that I have read the foregoing Registration Statement and that all of the items therein contained are true to the best of my knowledge and belief.

Harold H. Myers
(Signature of Registrant)

Subscribed and sworn to before me this 21st day of June, 1958

My commission expires _____
(Notary Public)

(SEAL)

CERTIFICATE OF REGISTRATION

STATE OF OREGON

County of Marion } ss.

This is to certify that the foregoing Registration Statement was received in the office of the State Engineer on the 25th day of June, 1958, at 8:00 o'clock A.M. and has been duly recorded in said office in Book No. 8 of Registration Statements on page GR-1745

~~Construction shall be completed by _____ and the water completely applied to _____~~

Witness my hand this 7th day of January, 1959

Lewis A. Stanley
(State Engineer)

\$15.00

By _____ (Deputy)

GR-1745