

Registration Statement

OF CLAIMANT OF RIGHT TO APPROPRIATE GROUND WATER

TO THE STATE ENGINEER OF OREGON:

I, Hewett Warrens
of 4090 SW 185th, Aloha, Ore County of Wash
(Mailing address)

State of Ore., do hereby make application for a certificate of registration as evidence of a right to appropriate ground water.

1. Source from which water is withdrawn is Pump Well
(Flowing well, pump well, infiltration trench, or tunnel)

2. Location is: Approx 1/4 mi S of Aloha City Center
(Approximate distance and direction from nearest city or town)

and is more particularly described as follows: 660 feet South & 300 feet east from NW corner Section 18

(a) Lot 33 Beaverton-Reedville Acreage with exceptions
(Give distance and bearing to corner of section or other legal subdivision)

being within NW 1/4 of NW 1/4 of Sec. 18, Twp. 15, Rge. 1W
(Smallest legal subdivision) (S. or S.) (E. or W.)

or (b) within limits of recorded platted property, town or city: _____

in Lot _____, Block _____ of _____
(Name of plat or addition)

Aloha County of Washington
(If within city or town, give name)

3. Construction Work was begun on unknown; was completed on 1930
(Date) (Date)

and the ground water claimed was first used for the purposes set out below on prior to 1930,
(Date)

since which time the water has been used int
(Continuously or Intermittently)

from 1930 to Oct 1957
(Date) (Date)

4. Quantity of water claimed and used is 25 gallons per minute; _____ acre feet per year.

5. Purpose or Purposes for which water is used irrigation

(Domestic, irrigation, municipal, manufacturing, industrial, etc.)

6. Description of Well: Depth 27 feet. Type Dug
(Dug or drilled)

diameter 7 1/2 inches. Elevation of ground at well site 200 feet, mean sea level.
(As near as known)

Depth to water table 2'-0" winter
19'-0" Fall

7. Capacity of Well: 14.4 g.p.m. with 4 feet drawdown: after one hr.

_____ g.p.m. with _____ feet drawdown.

Date of test _____

If Flowing Well: Measured discharge _____ g.p.m. on _____
(Date)

Shut-in pressure at ground surface _____ lbs. per sq. in. on _____
(Date)

Water is controlled by _____
(Cap, valve, etc.)

8. Casing: (Give diameter, commercial specifications and depth below ground surface of each casing size.)

6' 0" inch diameter Brick from 0 to 27 feet
inch diameter from to feet
inch diameter from to feet
inch diameter from to feet

Describe and show depth of shoe, plug, adapter, liner or other details:

9. Perforated Casings or Screens:

None from to
(Number per foot and size of perforations, or describe screen)
from to
from to
from to

10. Log of Well: (Describe each stratum or formation clearly, indicate if water bearing, and give thickness and depth as indicated.)

MATERIAL	Thickness (Feet)	Depth to Bottom (Feet)
Not known		

If log of well is not available, give name and address of driller. NOT KNOWN

11. Infiltration Trench: Covered or open _____
 Dimensions: Length _____ ft. Minimum depth _____ ft. Maximum depth _____ ft.

Bottom width _____ ft. Discharge _____ g.p.m. Date of test _____

12. Tunnel: Type of lining _____

Dimensions: _____
(Length, course, and cross sectional size)

Position of water bearing stratum with reference to portal of tunnel _____

Log of tunnel: (Preceding table for log of well may be used, if desired. Give footage from portal and character of materials, as pertinent.)

13. Pumping Equipment:

(a) Pump HOMART JET Capacity 25.4 g.p.m.
(Make, type and size)


(b) Motor 1 H.P. 110-220
(Type and horsepower)

14. Location of area irrigated or to be irrigated, or place of use if for purposes other than irrigation.

Township North or South	Range E. or W. of Willamette Meridian	Section	Forty-acre Tract	Number Acres To Be Irrigated	Date of Reclamation
T15	R1W	18	NW ¹ / ₄ of NW ¹ / ₄	1.0 Ac	1950

15. If the ground water supply is supplemental to an existing water supply, identification of any application for a permit, permit, certificate or adjudicated right to appropriate water made or held by the registrant.

Township 15 Range 1W, W.M.
North

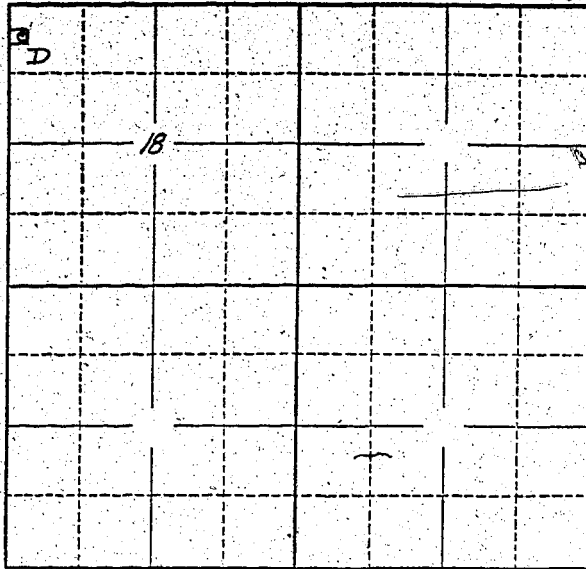

Locate well and acreage of irrigated land on plat.
Scale: 2" = 1 Mile

STATE OF OREGON

County of Marion } ss.

I, Hewitt Stevens, being first duly sworn, do hereby certify that I have read the foregoing Registration Statement and that all of the items therein contained are true to the best of my knowledge and belief.

Hewitt Stevens
(Signature of Registrant)

Subscribed and sworn to before me this 25th day of June, 19 58

My commission expires 12th June 1961 Wm. S. Bartholomew
(Notary Public)

(SEAL)

CERTIFICATE OF REGISTRATION

STATE OF OREGON

County of Marion } ss.

This is to certify that the foregoing Registration Statement was received in the office of the State Engineer on the 25th day of June, 19 58, at 11:00 o'clock A. M. and has been duly recorded in said office in Book No. 8 of Registration Statements on page GR-1748

Witness my hand this 7th day of January, 19 59

\$15.00

Lewis A. Stanley
(State Engineer)

By _____
(Deputy)

GR-1748