

# Registration Statement

## OF CLAIMANT OF RIGHT TO APPROPRIATE GROUND WATER

TO THE STATE ENGINEER OF OREGON:

I, Lloyd W. Oddy

of 518 So. Cows St., McMinnville County of Yamhill

State of Oregon, do hereby make application for a certificate of registration as evidence of a right to appropriate ground water.

1. Source from which water is withdrawn is Pump well  
(Flowing well, pump well, infiltration trench, or tunnel)

2. Location is: One mile due West of McMinnville, Oregon  
(Approximate distance and direction from nearest city or town)

and is more particularly described as follows:

(a) 300 feet east & 410 feet south from W 1/4 corner Section 20  
(Give distance and bearing to corner of section or other legal subdivision)

being within NW 1/4 of SW 1/4 of Sec. 20, Twp. 4S, Rge. 4W  
(Smallest legal subdivision) (S. or S.) (W. or W.)

(b) within limits of recorded platted property, town or city:

in Lot 3, Block \_\_\_\_\_ of Fair Lawn Subdivision  
(Name of plat or addition)

County of Yamhill  
(If within city or town, give name)

3. Construction Work was begun on More than 30 years, was completed on 1928  
(Date) (Date)

and the ground water claimed was first used for the purposes set out below on April, 1951  
(Date)

since which time the water has been used continuously  
(Continuously or intermittently)

from 1951 to 1958 incl.  
(Date) (Date)

4. Quantity of water claimed and used is 35 gallons per minute; \_\_\_\_\_ acre feet per year.

5. Purpose or Purposes for which water is used irrigation

(Domestic, irrigation, municipal, manufacturing, industrial, etc.)

6. Description of Well: Depth 66 feet. Type dug cistern 33 ft. drilled 33 ft.  
(Dug or drilled)

diameter 6 inches. Elevation of ground at well site 157 ft. feet, mean sea level.  
(As near as known)

Depth to water table 4 feet.

7. Capacity of Well: 35 g.p.m. with 6 feet drawdown.

\_\_\_\_\_ g.p.m. with \_\_\_\_\_ feet drawdown.

Date of test 1951

If Flowing Well: Measured discharge \_\_\_\_\_ g.p.m. on \_\_\_\_\_  
(Date)


Shut-in pressure at ground surface \_\_\_\_\_ lbs. per sq. in. on \_\_\_\_\_  
(Date)

Water is controlled by \_\_\_\_\_  
(Cap, valve, etc.)





North

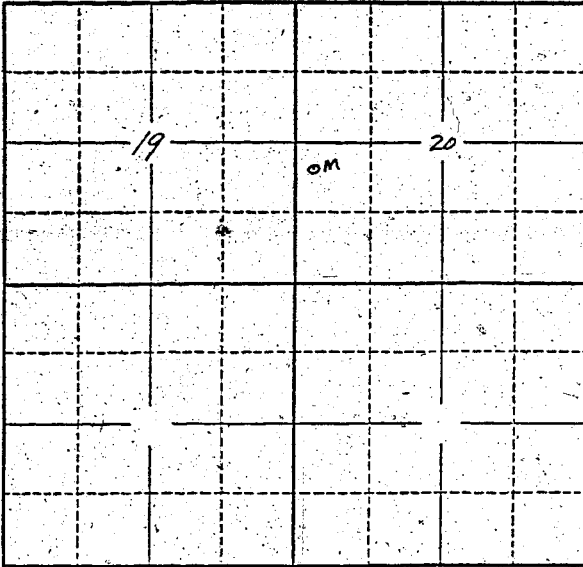

Locate well and acreage of irrigated land on plat.

Scale: 2" = 1 Mile

STATE OF OREGON

County of Yamhill Marion } ss.

I, Lloyd W. Oddy, being first duly sworn, do hereby certify that I have read the foregoing Registration Statement and that all of the items therein contained are true to the best of my knowledge and belief.

Lloyd W. Oddy  
(Signature of Registrant)

Subscribed and sworn to before me this 25th day of June, 1958

My commission expires 17th June 1961 Wm. S. Bartholomew  
(Notary Public)

(SEAL)

CERTIFICATE OF REGISTRATION

STATE OF OREGON }  
County of Marion } ss.

This is to certify that the foregoing Registration Statement was received in the office of the State Engineer on the 25th day of June, 1958, at 3<sup>00</sup> o'clock P. M. and has been duly recorded in said office in Book No. 8 of Registration Statements on page GR-1750

Witness my hand this 7th day of January, 1959  
Laura A. Stanley  
(State Engineer)

\$1,500

By \_\_\_\_\_ (Deputy)

GR-1750