

Registration Statement

OF CLAIMANT OF RIGHT TO APPROPRIATE GROUND WATER

TO THE STATE ENGINEER OF OREGON:

I, Neil L. Stephenson

of Jefferson, Oregon County of Maxion

State of Oregon, do hereby make application for a certificate of registration as evidence of a right to appropriate ground water.

1. Source from which water is withdrawn is PUMP Well
(Flowing well, pump well, infiltration trench, or tunnel)

2. Location is: 1 mi S. Jefferson
(Approximate distance and direction from nearest city or town)

and is more particularly described as follows:

(a) 1150' N & 850' W from SE corner section 14
(Give distance and bearing to corner of section or other legal subdivision)

being within SE¹/₄ SE¹/₄ of Sec. 14, Twp. 10 S, Rge. 2 W
(Smallest legal subdivision) (N. or S.) (E. or W.)

or (b) within limits of recorded platted property, town or city: _____

in Lot _____, Block _____ of _____
(Name of plat or addition)

County of _____
(If within city or town, give name)

3. Construction Work was begun on June 1954; was completed on June 1954
(Date) (Date)

and the ground water claimed was first used for the purposes set out below on June 1954
(Date)

since which time the water has been used intermittently
(Continuously or Intermittently)

from MAY to OCT.
(Date) (Date)

4. Quantity of water claimed and used is 210 gallons per minute; _____ acre feet per year.

5. Purpose or Purposes for which water is used irrigations
(Domestic, irrigation, municipal, manufacturing, industrial, etc.)

6. Description of Well: Depth 21 feet. Type Driven
(Dug or drilled)

diameter 4 inches. Elevation of ground at well site _____ feet, mean sea level.
(As near as known)

Depth to water table 3 feet.

7. Capacity of Well: _____ g.p.m. with _____ feet drawdown.

_____ g.p.m. with _____ feet drawdown.

Date of test _____

If Flowing Well: Measured discharge _____ g.p.m. on _____
(Date)

Shut-in pressure at ground surface _____ lbs. per sq. in. on _____
(Date)

Water is controlled by _____
(Cap, valve, etc.)

8. Casing: (Give diameter, commercial specifications and depth below ground surface of each casing size.)

4 inch diameter from 0 to 21 feet
 inch diameter from to feet
 inch diameter from to feet
 inch diameter from to feet

Describe and show depth of shoe, plug, adapter, liner or other details:

9. Perforated Casings or Screens:


Perforated from to
(Number per foot and size of perforations, or describe screen)
 from to
 from to
 from to

10. Log of Well: (Describe each stratum or formation clearly, indicate if water bearing, and give thickness and depth as indicated.)

MATERIAL	Thickness (Feet)	Depth to Bottom (Feet)
Soil 2ft then GRAVEL		

R

Township 10S Range 3W, W.M.
North

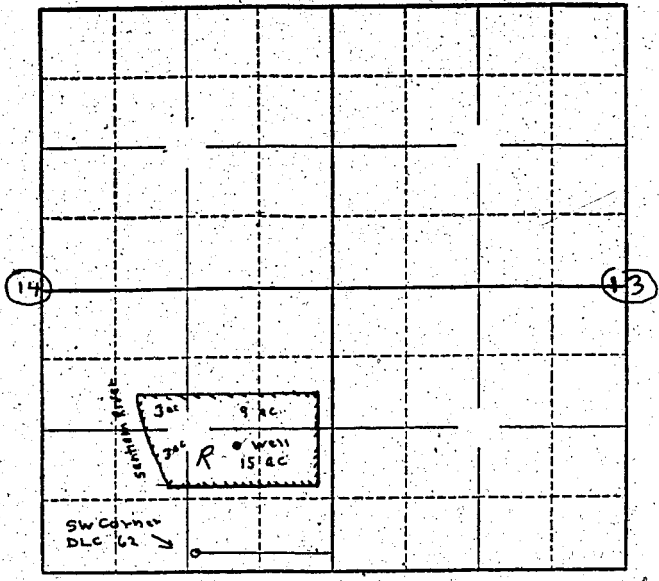

Locate well and acreage of irrigated land on plat.

Scale: $\frac{1}{4}$ " = 1 Mile

STATE OF OREGON

County of Marion } ss.

I, Neil S. Stephenson, being first duly sworn, do hereby certify that I have read the foregoing Registration Statement and that all of the items therein contained are true to the best of my knowledge and belief.

Neil S. Stephenson
(Signature of Registrant)

Subscribed and sworn to before me this 26th day of June, 1958.

My commission expires 12th June 1961 Wm. S. Bartholomew
(Notary Public)

(SEAL)

CERTIFICATE OF REGISTRATION

STATE OF OREGON

County of Marion } ss.

This is to certify that the foregoing Registration Statement was received in the office of the State Engineer on the 26th day of June, 1958 at 11:45 o'clock A. M. and has been duly recorded in said office in Book No. 8 of Registration Statements on page GR-1759

Witness my hand this 7th day of January, 1959

Henry A. Stanley
(State Engineer)

By _____
(Deputy)

#1500